

LAND CORNER RECORDATION CERTIFICATE

FILING REQUIREMENT OF ACT 74, MICH. P.A. 1970
 Mackinac Co 4 corners.

FOR CORNERS OF--	LOCATED IN--	CORNER CODE NUMBER
1. PUBLIC LAND SURVEY _____	T. <u>44</u> N. R. <u>10</u> E. W.	<u>D-3</u> <u>C-3</u> <u>C-4</u>
2. PROPERTY CONTROLLING IN SECTION _____	T. _____ N. S. R. _____ E. W.	_____
3. MISCELLANEOUS PROPERTY IN SECTION _____	T. _____ N. S. R. _____ E. W.	_____
4. LOT NO. _____, RECORDED PLAT _____		
5. PRIVATE CLAIMS _____		

REGISTER OF DEEDS STAMP AND FILING NUMBER

I, Billy D. Buckler, do hereby certify that under requirements of P.A. 74, Michigan P.A. of 1970, the corner points mentioned in lines 1 and 2 above were, in a field survey on 5/7, 1976, established, re-established, monumented, re-monumented, recovered or restored as expressed below and in conformance with regulations and rules therefore as required in the current manual of survey instructions of the United States Department of the Interior, Bureau of Land Management or by a decree of a court of law. Furthermore, that the corner points mentioned in lines 3, 4 and 5 above were, in a field survey on _____, 19____, found, recovered, restored, established or re-established as expressed below and in conformance with the rules of the Michigan State Board of Registration for Land Surveyors or, by a Decree of a Court of law:

A. Description of original monument and accessories and/or subsequent restoration:

All corners placed by William Ives, D.S. in 1849.

- D-3** Quarter Corner bet. Sec's. 5-8. Bearings were: Cedar 4", N49°E, 09 lks. and Cedar 6", S35°W, 19 lks.
- C-3** Sec. Cor. 5-6-7-8. Bearings were: Maple 16", S45°E, 19 lks. and Sugar 10", N30°W, 07 lks. (The record corrects corner set 10-31-69.)
- C-5** Sec. Cor. 7-8-17-18. Bearings were: Sugar 14", S45°E, 16 lks. and Beech 9", N35°W, 11 lks. (This record corrects corner set 12/11/69.)
- C-4** Quarter Cor. bet. Sec's. 7-8. Bearings were: Sugar 10", S30°W, 14 lks. and Fir 7", N55°E, 15 lks.

B. Description of corner evidence found and/or method applied in restoring or re-establishing corner:


- D-3** Corner re-established by single proportionate measure, bet. Sec. Cor. $\frac{1}{2}$ mile West and an original W. Pine line tree 2,332.4' East. Corner lies in a green Cedar Swp.
- C-3** Corner re-established by proportionate measure to North and South and at record distance from a fence corner $\frac{1}{2}$ mile West. Corner lies on North edge of an old R.R. grade.
- C-5** Corner re-established by double proportionate measure from four directions. Found stream 660' North to check. No evidence of original corner.
- C-4** Corner re-established by single proportionate measure, bet. two Sec. Corners. Found no evidence of original corner.

C. Description of monument for corner and accessories established to perpetuate locating the position of the corner:

Placed 1" pipe with 4" aluminium cap at all corners.

- D-3** New Bearings: 16" Cedar, S84°W, 19.5' and 16" Hemlock, S47°E, 37.9'
- C-3** New Bearings: 12" B. Cherry, N78°E, 16.6' and 10" B. Cherry, S40°W, 53.1'
- C-5** New Bearings: 7" Cherry, N86°E, 20.9' and 10" Cherry, S5°E, 51.0'
Corner lies 65' South of woods road.
- C-4** New Bearings: 5" Soft Maple, N21°W, 33.0' and 6" Soft Maple, S12°E, 26.7'
Corner lies 13' North of an old R.R. grade.

SIGNED BY Billy D. Buckler
 Billy D. Buckler
 SURVEYOR'S MICHIGAN REGISTRATION NO. 8887

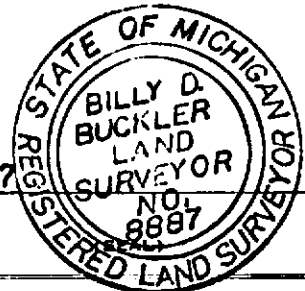

FOR STATE AND UNITED STATES AGENCIES:

SIGNED BY _____ DATE _____
CHIEF OF SURVEY PARTY
 APPROVED AND SIGNED BY _____ DATE _____
MICHIGAN REGISTERED LAND SURVEYOR

(SEAL)

SURVEYOR'S MICHIGAN REGISTRATION NO. _____