

# LAND CORNER RECORDATION CERTIFICATE

**FILING REQUIREMENT OF ACT 74, MICH. P.A. 1970**  
 Mackinac Co. 3 Corners

FOR CORNERS OF--	LOCATED IN--	CORNER CODE NUMBER
1. PUBLIC LAND SURVEY _____	T. <u>44</u> N. R. <u>10</u> E. W.	1-Sec. 5, 4-Sec. 5
2. PROPERTY CONTROLLING IN SECTION <u>5</u>	T. <u>44</u> N. R. <u>10</u> E. W.	6-Sec. 5
3. MISCELLANEOUS PROPERTY IN SECTION _____	T. _____ N. R. _____ E. W.	
4. LOT NO. _____, RECORDED PLAT _____		
5. PRIVATE CLAIMS _____		

REGISTER OF DEEDS STAMP AND FILING NUMBER

I, Billy D. Buckler, do hereby certify that under requirements of P.A. 74, Michigan P.A. of 1970, the corner points mentioned in lines 1 and 2 above were, in a field survey on 8-9, 1979, established, re-established, monumented, re-monumented, recovered or restored as expressed below and in conformance with regulations and rules therefore as required in the current manual of survey instructions of the United States Department of the Interior, Bureau of Land Management or by a decree of a court of law. Furthermore, that the corner points mentioned in lines 3, 4 and 5 above were, in a field survey on \_\_\_\_\_, 19\_\_\_\_, found, recovered, restored, established or re-established as expressed below and in conformance with the rules of the Michigan State Board of Registration for Land Surveyors or, by a Decree of a Court of law:

A. Description of original monument and accessories and/or subsequent restoration:  
**1-Sec. 5** West 1/16 Corner on North side of Sec. 5.

**4-Sec. 5** Northwest 1/16 Corner of Section 5.

**6-Sec. 5** Northeast 1/16 Corner of Section 5.

B. Description of corner evidence found and/or method applied in restoring or re-establishing corner:  
**1-Sec. 5** Placed corner midway and on line with  $\frac{1}{2}$  Cor. to East and Sec. Cor. to West. Corner lies 12.0' South of E-W road.


**4-Sec. 5** Placed corner at center of NW  $\frac{1}{4}$  Section.

**6-Sec. 5** Placed corner at center of NE  $\frac{1}{4}$  Section.

C. Description of monument for corner and accessories established to perpetuate locating the position of the corner:  
 Placed 1" pipe with 4" aluminium cap at all corners. Bearings:  
**1-Sec. 5** 12" S. Maple, N35°E, 29.6' & 8" S. Maple, S19°E, 19.4' & 10" S. Maple, S74°W, 32.1'.  
**4-Sec. 5** 6" S. Maple, N52°W, 28.4' & 16" Beech, S7°E, 16.0' & 16" Hemlock, S53°E, 41.3'.  
**6-Sec. 5** 8" S. Maple, N83°E, 26.3' & 10" Beech, S57°W, 11.8' & 10" S. Maple, S67°E, 8.4'.

SIGNED BY Billy D. Buckler  
 Billy D. Buckler  
 SURVEYOR'S MICHIGAN REGISTRATION NO. 8887

DATE 10-23-79

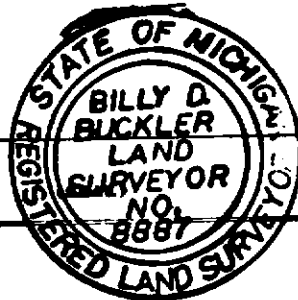

FOR STATE AND UNITED STATES AGENCIES:

SIGNED BY \_\_\_\_\_ DATE \_\_\_\_\_  
CHIEF OF SURVEY PARTY  
 APPROVED AND SIGNED BY \_\_\_\_\_ DATE \_\_\_\_\_  
MICHIGAN REGISTERED LAND SURVEYOR (SEAL)

SURVEYOR'S MICHIGAN REGISTRATION NO. \_\_\_\_\_