

SURVEY & REMONUMENTATION

JAN 21 1999

LAND CORNER RECORDATION CERTIFICATE
Filing Requirement of Act 74, Mich. P.A. 1970
Mackinac County Remonumentation Corner

SECTION

For corners in

Mackinac County	Located in:	Corner Code #
1. Public Land Survey	T44N R11W	M-1 Mackinac
	Same T44N R10W	A-1 County ✓
Corner	T45N R10W	A-13 Luce
	T45N R11W	M-13 County
2. Property Controlling in Section	S T R	
	S T R	
3. Miscellaneous Property in Sec.	S T R	
	S T R	
4. Lot No.	Recorded Plat	
5. Private Claims		

RECEIVED & FILED
DIANE FRANKOVICH
 MACKINAC COUNTY REGISTER OF DEEDS

DEC 31 1998

AM PM
 7|8|9|10|11|12|1|2|3|4|5|6

ACCEPTED BY THE MACKINAC COUNTY SURVEY PEER GROUP AS THE OFFICIAL CORNER UNDER P.A. 345 OF 1990 AT A MEETING HELD ON 11-20-98 NEH

Register of Deeds Stamp & File Number

	A	B	C	D	E	F	G	H	I	J	K	L	M
1													
2	6		5		4		3		2				
3													
4	7		8		9		10		11		12		
5													
6	18		17		16		15		14		13		
7													
8	19		20		21		22		23		24		
9													
10	30		29		28		27		26		25		
11													
12	31		32		33		34		35		36		
13													

I, William L. Karr, in a field survey on December 7, 1998, do hereby state that under requirements of P.A. 74, Michigan P.A. of 1970, the corner points mentioned in lines 1 and 2 above were in conformance with regulations and rules therefore as required in the current manual of survey instructions of the United States Department of the Interior, Bureau of Land Management or by a decree of a Court of Law and/or that the corner points mentioned in lines 3, 4 and 5 above were in conformance with the rules of the Michigan Board of Land Surveyors or by a Decree of a Court of Law; established, re-established, monumented, recovered, found as expressed below:

NOTE: Not more than 2 corners, all in the same town and range, may be recorded on this certificate.

A. Description of original monument and accessories and/or subsequent restoration:

(M-1) Township Corner Common to Townships T45N-R11W, T45N-R10W, T44N-R11W and T44N-R10W

1841 John Burt set a post for the township corner in the original survey.
 Witnesses: 12" Sugar Maple N 75° E 69 lks
 15" Beech S 60° W 27 lks

1960 Billy Buckler, P.S. 8887, found an old cedar post at the intersection of old township roads South and East. Buckler re-monumented the corner with a 1" pipe with a 4" Dept. of Conservation brass cap and recorded the corner in 1961 in page 428 of the Luce County Corner Records.

B. Description of corner evidence found and/or method applied in restoring or reestablishing corner:

(M-1) Township Corner Common to Townships T45N-R11W, T45N-R10W, T44N-R11W and T44N-R10W
 This corner is being perpetuated as part of the Luce County Remonumentation Program.

Recovered Buckler's corner as monumented in 1960. Could find no evidence of the original corner or any other contrary evidence. Accepted Buckler's monument for the township corner.

C. Description of monument for corner and accessories established to perpetuate locating the position of the corner:

(M-1) Township Corner Common to Townships T45N-R11W, T45N-R10W, T44N-R11W and T44N-R10W

Corner is a 1" pipe with a 4" stamped Dept. of Conservation brass cap. The corner falls on the intersecting centerlines of old roads South and East.


Witnesses: Sugar Maple 8" N 11° E 21.07'
 Red Maple 16" N 30° E 33.34'
 Red Maple 10" N 71° E 15.16'
 Beech 1 3" N 71° W 34.41'

Bearings are compass bearings, corrected for declination, all distances are to a nail and tag in the side of the witness, unless otherwise noted.

Signed by William L. Karr

Date 12/22/98

Surveyor's Michigan License No. 27450

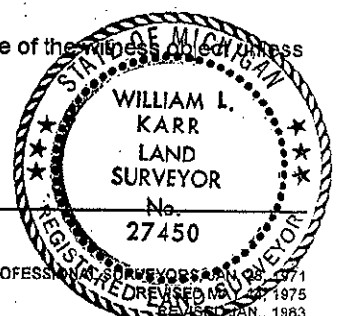

FORM APPROVED BY MICHIGAN STATE BOARD OF PROFESSIONAL SURVEYORS JAN 28 1975
 REVISED MAY 1975
 REVISED JAN., 1983
 REVISED OCT., 1995