

1995 Mackinac County Remonumentation Corner

LAND CORNER RECORDATION CERTIFICATE
Filing Requirement of Act 74, Mich. P.A. 1970

For corners in Mackinac (County) Located In: _____ Corner Code # _____

1. Public Land Survey	T <u>44N</u> R <u>10W</u>	<u>A-7</u>
	T _____ R _____	_____
	T _____ R _____	_____
	T _____ R _____	_____
2. Property Controlling in Section	S _____ T _____ R _____	_____
	S _____ T _____ R _____	_____
3. Miscellaneous Property in Section	S _____ T _____ R _____	_____
	S _____ T _____ R _____	_____

RECEIVED & FILED
DIANE FRANKOVICH
MACKINAC COUNTY REGISTER OF DEEDS

NOV - 7 1995

AM _____ PM _____
7|8|9|10|11|12|1|2|3|4|5|6

Register of Deeds Stamp & File Number

4. Lot No. _____, Recorded Plat _____
5. Private Claims _____

	A	B	C	D	E	F	G	H	I	J	K	L	M
2	6		5		4		3		2		1		
3													
4	7		8		9		10		11		12		
5													
6	18		17		16		15		14		13		
7													
8	19		20		21		22		23		24		
9													
10	30		29		28		27		26		25		
11													
12	31		32		33		34		35		36		
13													

I, David B. Guthrie in a field survey on 6/14, 1995, do hereby certify that under requirements of P.A. 74, Michigan P.A. of 1970, the corner points mentioned in lines 1 and 2 above were in conformance with regulations and rules therefore as required in the current manual of survey instructions of the United States Department of the Interior, Bureau of Land Management or by a decree of a Court of Law and/or that the corner points mentioned in lines 3, 4 and 5 above were in conformance with the rules of the Michigan Board of Professional Surveyors or by a Decree of a Court of Law; established, re-established, monumented, re-monumented, recovered, found as expressed below:

NOTE: Not more than 4 corners, all in the same town and range, may be recorded on this certificate.

A. Description of original monument and accessories and/or subsequent restoration:

- 1841: Established by Wm. Burt, G.L.O. Survey - Set post and referenced Hemlock 10 - N34E 4020' / Maple 14 - N78W 4525
- 1966: Preliminary Survey by Kimberly Clark Corp.
- 1981: Survey by Eino Sainio - Set 1 1/4"x18" Iron Pipe and Cedar post from preliminary survey by Kimberly Clark Corp.
- 1994: Road Design Survey by R.S. Scott Assoc. - Set 5/8" Iron Rod from 1981 Eino Sainio references.

B. Description of corner evidence found and/or method applied in restoring or reestablishing corner:

- 1995: Found 5/8" Iron Rod


SURVEY & REMONUMENTATION

DEC 01 1995

COMM-FS

ACCEPTED BY THE MACKINAC COUNTY SURVEY PEER GROUP AS THE OFFICIAL CORNER UNDER P.A. 345 OF 1990 AT A MEETING HELDON 9-10-95

Jane H. Kranger

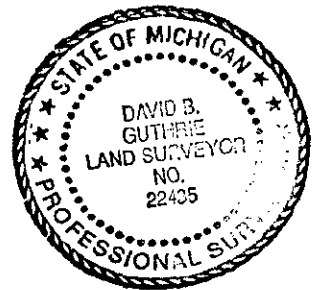

C. Description of monument for corner and accessories established to perpetuate locating the position of the corner:

- 1995: Placed a 3" Aluminum Cap on the 5/8"x24" Iron Rod. The Aluminum Cap was stamped to identify the corner. The corner was placed 6" below the gravel surface.
- Referenced - (Exist.) S07°E - 8" Hemlock - 44.88 Feet
- (Exist.) S49°W - 8" Birch - 48.18 Feet
- S30°E - 4" Balsam - 37.65 Feet
- S07°E - 8" Hemlock - 45.97 Feet (Tag)
- S54°W - 7" Hemlock - 63.58 Feet
- N06°E - 4"x4" Wood Post - 49.35 Feet

Signed by David B. Guthrie
Surveyor's Michigan License No. 22435

Date 9/19/95