

**LAND CORNER RECORDATION CERTIFICATE**  
**Filing Requirement of Act 74, Mich. P.A. 1970**

For corners in

Mackinac

(County)

Located In:

Corner Code #

1. Public Land Survey

T 44N R 10W

A6

T R

T R

T R

2. Property Controlling  
in Section

S 18 T 44N R 10W

5

S T R

3. Miscellaneous  
Property in Sec.

S T R

S T R

Register of Deeds Stamp & File Number

4. Lot No. \_\_\_\_\_, Recorded Plat \_\_\_\_\_

5. Private Claims \_\_\_\_\_

A6 Aug 14 2002

5 Jul 03 2002

I, Stephan J. Szyszkoski, in a field survey on \_\_\_\_\_, 20\_\_ do hereby state that under requirements of P.A. 74, Michigan P.A. of 1970, the corner points mentioned in lines 1 and 2 above were in conformance with regulations and rules therefore as required in the current manual of survey instructions of the United States Department of the Interior, Bureau of Land Management or by a decree of a Court of Law and /or that the corner points mentioned in lines 3, 4 and 5 above were in conformance with the rules of the Michigan Board of Land Surveyors or by a Decree of a Court of Law, established, re-established, monumented, recovered, found as expressed below:

NOTE: Not more than 2 corners, all in the same town and range, may be recorded on this certificate.

|    | A | B  | C | D  | E | F  | G | H  | I | J  | K | L  | M |
|----|---|----|---|----|---|----|---|----|---|----|---|----|---|
| 1  |   |    |   |    |   |    |   |    |   |    |   |    |   |
| 2  |   | 6  |   | 5  |   | 4  |   | 3  |   | 2  |   | 1  |   |
| 3  |   |    |   |    |   |    |   |    |   |    |   |    |   |
| 4  |   | 7  |   | 8  |   | 9  |   | 10 |   | 11 |   | 12 |   |
| 5  |   |    |   |    |   |    |   |    |   |    |   |    |   |
| 6  | ● | 18 |   | 17 |   | 16 |   | 15 |   | 14 |   | 13 |   |
| 7  |   |    |   |    |   |    |   |    |   |    |   |    |   |
| 8  |   | 19 |   | 20 |   | 21 |   | 22 |   | 23 |   | 24 |   |
| 9  |   |    |   |    |   |    |   |    |   |    |   |    |   |
| 10 |   | 30 |   | 29 |   | 28 |   | 27 |   | 26 |   | 25 |   |
| 11 |   |    |   |    |   |    |   |    |   |    |   |    |   |
| 12 |   | 31 |   | 32 |   | 33 |   | 34 |   | 35 |   | 36 |   |
| 13 |   |    |   |    |   |    |   |    |   |    |   |    |   |

**A. Description of original monument and accessories and/or subsequent restoration:**

(A6) Quarter corner common to Sections 18 T44N-R10W and 13 T44N-R11W. 1841: Established by Wm A. Burt: North on East side of Section 13 T44N-R11W...40.00 Set qr section post. Birch 14 N13E 45, Sugar 18 N68W 12...80.00 Set post corner Secs. 12 & 13.  
 (5-Sec. 18) North 1/16 corner, Section 18. Not established in the original survey.


**B. Description of corner evidence found and/or method applied in restoring or reestablishing corner:**

(A6) The original post and accessories were not recovered. Found no acceptable evidence of the position of the original corner on the ground. Reestablished the corner midway and on a line of mean true bearing between Section corners 2626.39' north and south, being proportionate to the original record. The corner falls in the center of a N-S road.  
 (5-Sec. 18) Established the corner midway and on a straight line between Center of Section (unmonumented) 1315.91' south and Quarter corner 1315.91' north.

**C. Description of monument for corner and accessories established to perpetuate locating the position of the corner:**

(A6) Set 1"ID I.pipe with yellow plastic cap stamped "MICH DMR LS33986", buried 6" below the road surface. Blazed, scribed and set measuring nails in :  
 4" Scotch Pine S43W 85.2' "1/4S NBT"  
 5" Scotch Pine S86E 40.25' do  
 Placed nails with tags in:  
 P.Pole (new) N23W 75.65'  
 P.Pole (new) S17W 188.4'  
 Bearings are magnetic. Distances to nail with tag.

(5) Set 1"IDx36" I.pipe with 4" alum. MDNR cap. Blazed, scribed, and set measuring nails in:  
 6" Maple N28W 3.0' "N1/16 8T"  
 6" Maple N08E 9.0' do  
 6" Maple S21W 15.45' do  
 10" Hemlock S36E 22.6' do  
 Placed cedar post adjacent. Bearings are magnetic. Distances are to nail with tag.

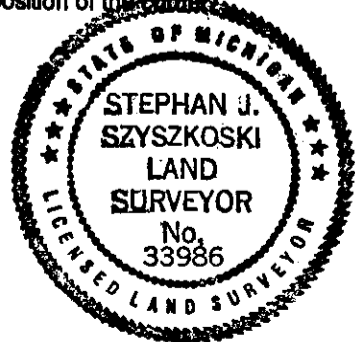

Signed by Stephan J. Szyszkoski  
 Surveyor's Michigan License No. 33986

Date 10/14/02