

LAND CORNER RECORDATION CERTIFICATE
Filing Requirement of Act 74, Mich. P.A. 1970

For corners in

Mackinac

(County)

Located in:

Corner Code #

- | | | |
|------------------------------------|---------------------------|-----------|
| 1. Public Land Survey | T <u>44N</u> R <u>10W</u> | <u>C7</u> |
| | T _____ R _____ | _____ |
| | T _____ R _____ | _____ |
| | T _____ R _____ | _____ |
| 2. Property Controlling in Section | S _____ T _____ R _____ | _____ |
| | S _____ T _____ R _____ | _____ |
| 3. Miscellaneous Property in Sec. | S _____ T _____ R _____ | _____ |
| | S _____ T _____ R _____ | _____ |

Register of Deeds Stamp & File Number

4. Lot No. _____, Recorded Plat _____
 5. Private Claims _____

Aug 14 2002

I, Stephan J. Szyszkoski, in a field survey on _____, 20__ do hereby state that under requirements of P.A. 74, Michigan P.A. of 1970, the corner points mentioned in lines 1 and 2 above were in conformance with regulations and rules therefore as required in the current manual of survey instructions of the United States Department of the Interior, Bureau of Land Management or by a decree of a Court of Law and/or that the corner points mentioned in lines 3, 4 and 5 above were in conformance with the rules of the Michigan Board of Land Surveyors or by a Decree of a Court of Law; established, re-established, monumented, recovered, found as expressed below:

NOTE: Not more than 2 corners, all in the same town and range, may be recorded on this certificate.

A	B	C	D	E	F	G	H	I	J	K	L	M
1												
2	6		5		4		3		2		1	
3												
4	7		8		9		10		11		12	
5												
6	18		17		16		15		14		13	
7												
8	19		20		21		22		23		24	
9												
10	30		29		28		27		26		25	
11												
12	31		32		33		34		35		36	
13												

A. Description of original monument and accessories and/or subsequent restoration:

(C7) Corner common to Sections 17-18-19-20 T44N-R10W. 18 Sept. 1995: Remonumented by David B. Guthrie, PS 22435 and accepted by the Mackinac County Survey Peer Group as the official corner under P.A. 345 of 1990. See record filed in Book D of corner records, Page 0373, Mackinac Co. Records.

B. Description of corner evidence found and/or method applied in restoring or reestablishing corner:


(C7) The 1995 monument was destroyed by road grading activities on an unknown date between Sept. 1995 and April 2002. Reestablished the 1995 position by reference to the 1995 witnesses and the 10/26/1994 traverse measurements made under the direction of Mr. Guthrie, copies found in the County Remonumentation Program files. Recovered the record 14" Maple S40E 54.20'R with Mr. Guthrie's tag. The other witness trees have been destroyed. The witness Utility pole North 39.60'R has been cut off and appears to have been disturbed from its 1995 position. I used the traverse measurements (sketch on reverse) in conjunction with the recovered witness to determine the position most harmonious with the entire record. The corner falls in the center of an E-W gravel road.

C. Description of monument for corner and accessories established to perpetuate locating the position of the corner:

(C7) Set 1"IDx36" I.pipe with plastic cap "MICH DNR PS 33986" buried 6" below gravel surface. The trees following have upper and lower blaze, scribed.

- | | | |
|----------------------------------|-----------|----|
| 6" Spruce N30W 85.55' | "S18 NBT" | ** |
| 14" Maple S38E 54.14' | "S20 NBT" | * |
| P.Pole N69W 157.15' | | ** |
| P. Pole (cut 1' a.g.) N1W 41.56' | | * |

Bearings are magnetic. Distances are horizontal and to nail with tag. * denotes found 1995 tag. ** denotes set nail/MDNR tag.

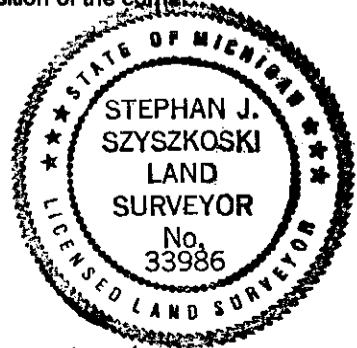

Signed by Stephan J. Szyszkoski
 Surveyor's Michigan License No. 33986

Date 10/14/02