


T44N R11W

Portage Twp.

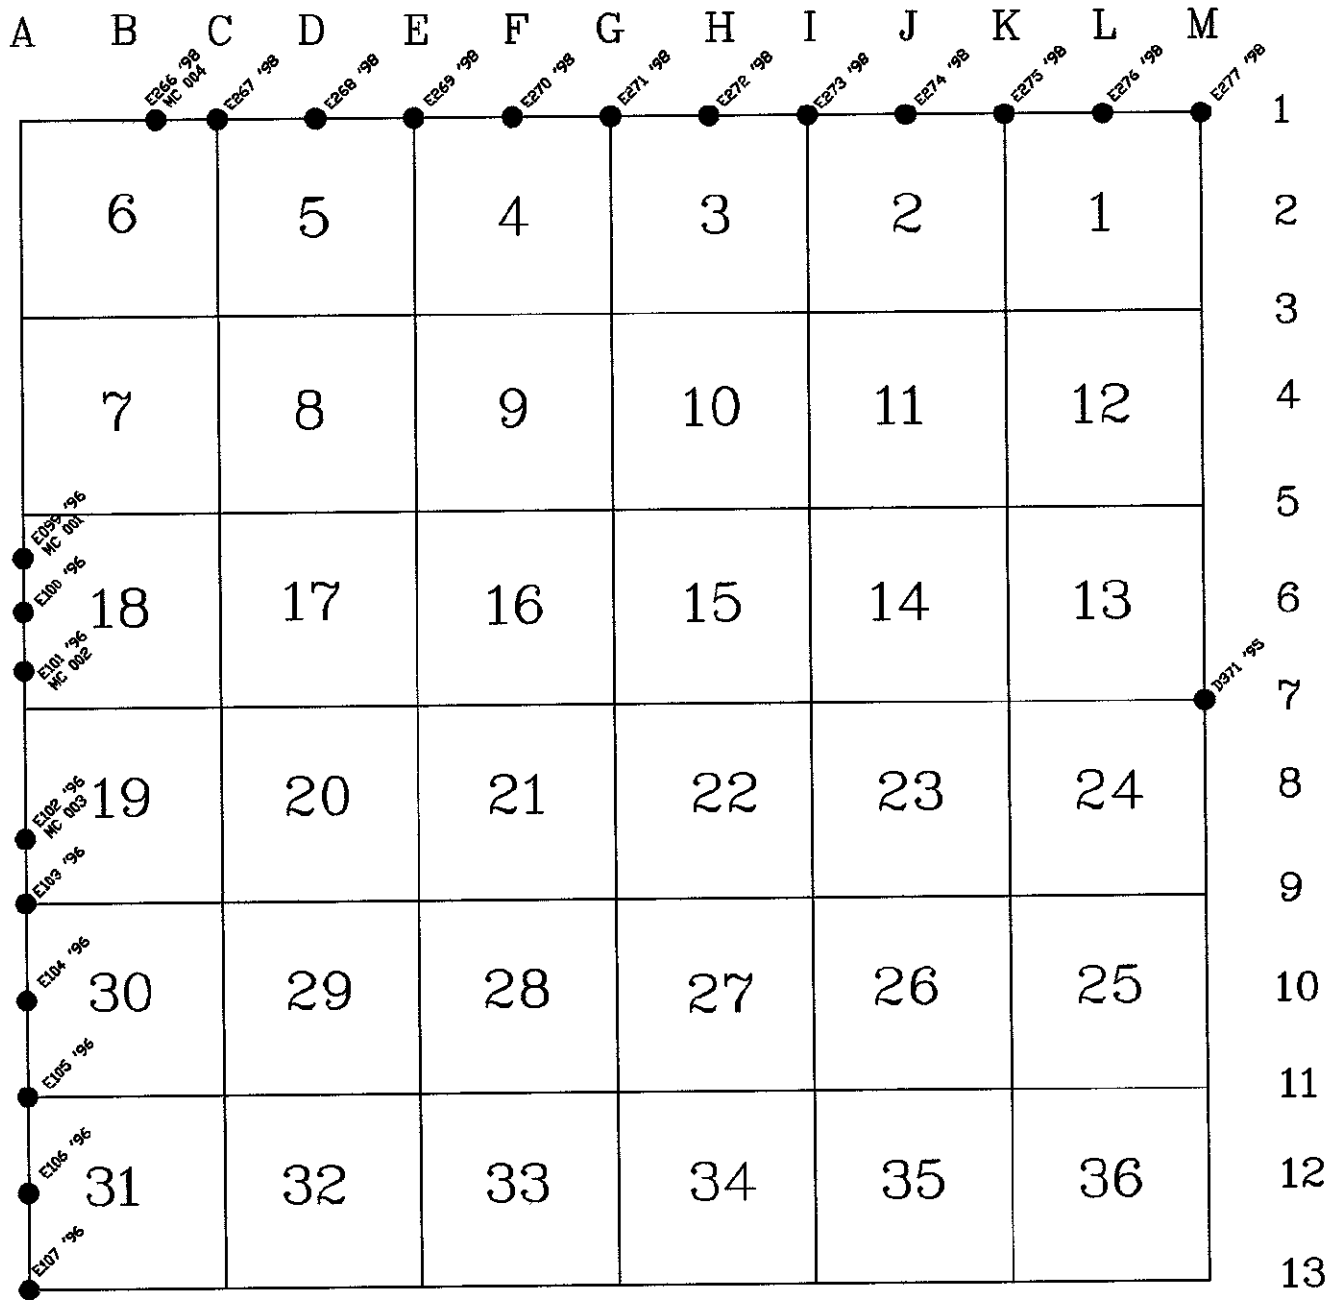

- Denotes Set ReMonumentation Corner in 1998
- Denotes Previously Set ReMonumentation Corner