

LAND CORNER RECORDATION CERTIFICATE

FILING REQUIREMENT OF ACT 74, MICH. P.A.1970

Mackinac Co.

2 Corners.

FOR CORNERS OF--	LOCATED IN--	CORNER CODE NUMBER
1. PUBLIC LAND SURVEY	T. <u>44</u> N. R. <u>11</u> W.	<u>C-13 & D-12</u>
2. PROPERTY CONTROLLING IN SECTION	T. _____ N. S., R. _____ E. W.	_____
3. MISCELLANEOUS PROPERTY IN SECTION	T. _____ N. S., R. _____ E. W.	_____
4. LOT NO. _____, RECORDED PLAT _____		
5. PRIVATE CLAIMS _____		

REGISTER OF DEEDS STAMP AND FILING NUMBER

I, Billy D. Buckler, do hereby certify that under requirements of P.A. 74, Michigan P.A. of 1970, the corner points mentioned in lines 1 and 2 above were, in a field survey on 5-31, 19 79, established, re-established, monumented, re-monumented, recovered or restored as expressed below and in conformance with regulations and rules therefore as required in the current manual of survey instructions of the United States Department of the Interior, Bureau of Land Management or by a decree of a court of law. Furthermore, that the corner points mentioned in lines 3, 4 and 5 above were, in a field survey on _____, 19____, found, recovered, restored, established or re-established as expressed below and in conformance with the rules of the Michigan State Board of Registration for Land Surveyors or, by a Decree of a Court of law:

A. Description of original monument and accessories and/or subsequent restoration:

C-13 Sec. Cor. 31-32, on South Boundary of Township set by Wm. A. Burt, D.S. in 1841. Bearings were: Cedar 10", S59°E, 34 lks. & Cedar 16", S57°W, 28 lks.

D-12 Center Corner of Section 32.

B. Description of corner evidence found and/or method applied in restoring or re-establishing corner:

C-13 Placed corner in center of old R.R. Grade and on line with corners in both directions: East and West.

D-12 Corner placed at intersection of lines connecting opposite quarter corners.

C. Description of monument for corner and accessories established to perpetuate locating the position of the corner:


Placed 1" pipe with 4" aluminium cap at both corners. New Bearings:

C-13 6" Cedar, S86°E, 15.6' & 6" Cedar, S34°E, 27.5'.

D-12 4" Cedar, S80°E, 47.8' & 8" W. Pine, S2°W, 98.2'.
Corner lies in NE Cor. of old clearing and 16' South of old grade.

SIGNED BY Billy D. Buckler
 Billy D. Buckler
 SURVEYOR'S MICHIGAN REGISTRATION NO. 8887

DATE 10-8-79

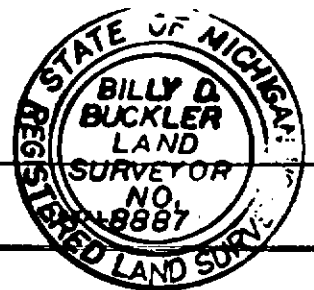

FOR STATE AND UNITED STATES AGENCIES:

SIGNED BY _____ DATE _____
CHIEF OF SURVEY PARTY
 APPROVED AND SIGNED BY _____ DATE _____
MICHIGAN REGISTERED LAND SURVEYOR

(SEAL)

SURVEYOR'S MICHIGAN REGISTRATION NO. _____