

MICHIGAN
DEPARTMENT OF CONSERVATION
FORESTRY DIVISION

LAND CORNER RECORD

T. 44N N.R. 11W


Mackinac COUNTY

DESCRIPTION OF CORNER Sec. Cor. common to Sees. 2-3-10-11

CORNER MONUMENT 1" pipe with 4" aluminum cap

DATE MONUMENT PLACED AND WITNESSED 8-27-69

WITNESSES TO CORNER..... 16" Hard Maple (S3 BT) N19°W

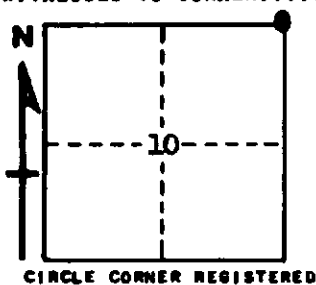

CIRCLE CORNER REGISTERED

AND

DESCRIPTION IN DETAIL AS TO HOW CORNER WAS LOCATED AND IDENTIFIED OR RESTORED.

This corner replaced at an old iron pipe. Found this pipe at intersection of old trail roads to south and east.

SURVEYOR'S SEAL

SIGNED *Billy D. Buckler*
Billy D. Buckler DATE 3-3-70
REGISTERED LAND SURVEYOR