

JAN 21 1999

SECTION

LAND CORNER RECORDATION CERTIFICATE
Filing Requirement of Act 74, Mich. P.A. 1970

For corners in

Mackinac

(County)

Located In:

Corner Code #

1. Public Land Survey

T44N R 11W II
T R
T R
T R
T R
S T R
S T R
S T R
S T R

2. Property Controlling in Section

3. Miscellaneous Property in Sec.

4. Lot No. , Recorded Plat

5. Private Claims

RECEIVED & FILED
DIANE FRANKOVICH
MACKINAC COUNTY REGISTER OF DEEDS

DEC 31 1998

AM PM
7|8|9|10|11|12|1|2|3|4|5|6

Register of Deeds Stamp & File Number

Aug 06 1998

I, Stephan J. Szyszkoski, in a field survey on, 19 do hereby state that under requirements of P.A. 74, Michigan P.A. of 1970, the corner points mentioned in lines 1 and 2 above were in conformance with regulations and rules therefore as required in the current manual of survey instructions of the United States Department of the Interior, Bureau of Land Management or by a decree of a Court of Law and /or that the corner points mentioned in lines 3, 4 and 5 above were in conformance with the rules of the Michigan Board of Land Surveyors or by a Decree of a Court of Law; established, re-established, monumented, recovered, found as expressed below:

NOTE: Not more than 2 corners, all in the same town and range, may be recorded on this certificate.

Grid table with columns A-M and rows 1-13. A dot is marked at the intersection of column I and row 1.

A. Description of original monument and accessories and/or subsequent restoration:

(I1) Corner common to Sections 2-3 T44N-R11W and 34-35 T45N-R11W. Corner established in 1841 by John Burt: "Set post corner of sections 34&35. W. Pine 22 N79E 19, Cedar 12 N50W 5." Additional bearing trees by Wm. Ives in 1849: Cedar 7 S35W 23, Cedar 11 S45E 24. Corner perpetuated in the original position in 1967 by Billy D. Buckler, RLS: "This corner replaced at an old cedar post with all four original witnesses in evidence; a W. Pine bearing N79E 19 lks, tree broken off about 3' high; three cedar stumps, cut 16" high bearing N50W 5 lks, S35W 23 lks, and S45E 24 lks. Found original faces with scribe marks on all stumps. Corner lies in a thick cedar swamp. Corner monument 1" pipe with 4" aluminum cap. Witnesses to corner 6" cedar (S35 N8T) N59E 4.2', 5" Cedar (S2 N8T) S75W 120'." Record dated 3-27-69.

B. Description of corner evidence found and/or method applied in restoring or reestablishing corner:


(I1) Recovered the 1967 monument as described, a 1" ID iron pipe capped with a 4" aluminum Michigan Dept. of Natural Resources tablet, in good condition, and at record bearing and distance from the remains of the original bearing trees as noted in the 1969 certificate. The remains have deteriorated and the scribing is no longer visible. Recovered the 1967 Cedar 6" in good condition. This tree was removed to facilitate GPS observations and is now a cut stump. The Cedar 5", noted in the record as being 120' distant, was recovered at 12.0' from the monument. The discrepancy is presumed to be a typographical error. This tree has fallen down. I accepted the monument as a careful and faithful perpetuation of the original corner and left it in place. I marked four new accessories as described below. Corner recovered and re-witnessed by T.Stark and M.Feldpausch, Newberry District Office.

C. Description of monument for corner and accessories established to perpetuate locating the position of the corner:

(I1) Found 1" iron pipe with aluminum MDNR cap. Blazed, scribed, and set measuring nails in the following:
5" Cedar N25E 13.7' "S35 N8T"
6" Cedar N04W 8.4' "S34 N8T"
6" Cedar S37E 16.9' "S2 N8T"
6" Cedar S55W 19.3' "S3 N8T"

Placed 4" squared and scribed cedar post adjacent. Bearings are magnetic.

ACCEPTED BY THE MACKINAC COUNTY SURVEY PEER GROUP AS THE OFFICIAL CORNER UNDER P.A. 345 OF 1990 AT A MEETING HELD ON 12-11-98 JEH

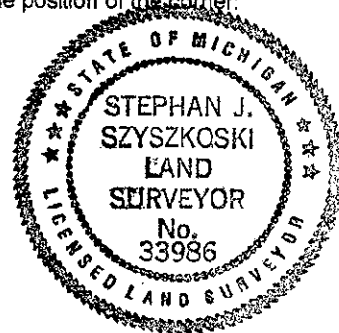

Signed by [Signature]
Surveyor's Michigan License No. 33986

Date 11-18-98

For the Michigan Department of Natural Resources - Forest Management Division