SURVEY &
REMONUMENTATION
JAN 21 1999
SECTION

T44N R12W

Portage Twp.

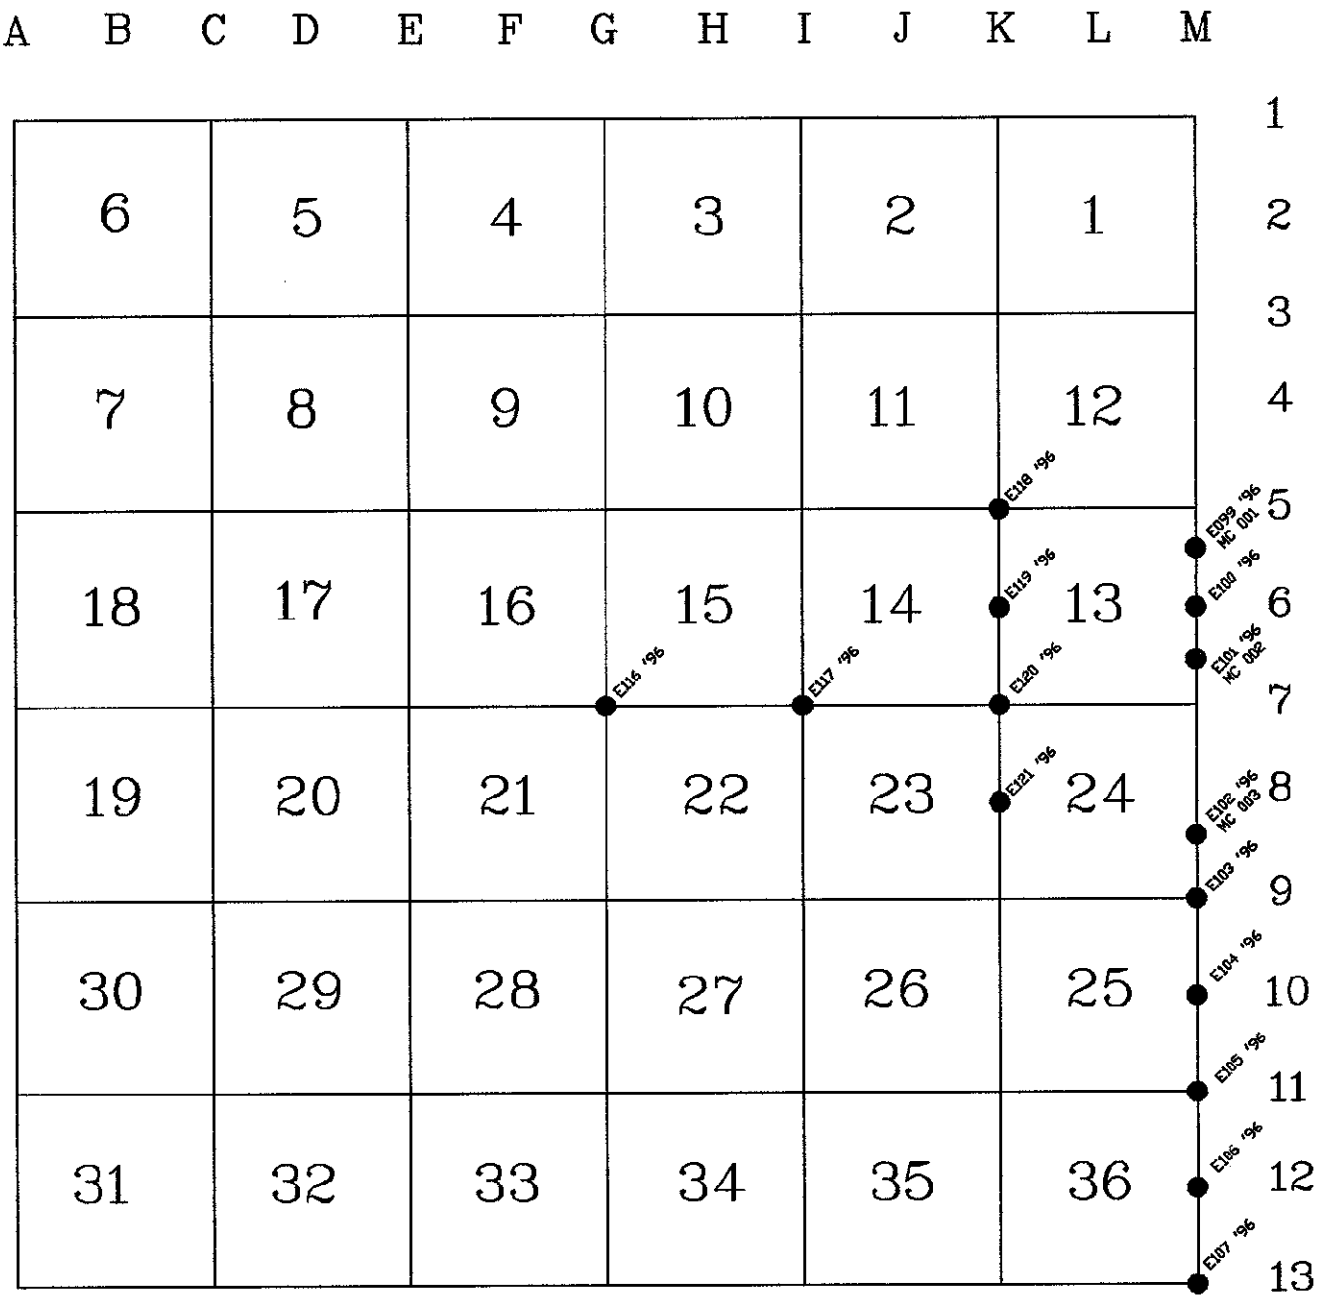

● Denotes Set ReMonumentation Corner in 1998

● Denotes Previously Set ReMonumentation Corner