

MACKINAC COUNTY REMONUMENTATION CORNER

MAY 20 1997

LAND CORNER RECORDATION CERTIFICATE
Filing Requirement of Act 74, Mich. P.A. 1970

For corners in
MACKINAC

COMMISSION

Located In: Corner Code #

- | | | |
|------------------------------------|-----------------------------|------------|
| 1. Public Land Survey | T <u>44</u> N R <u>12</u> W | <u>G-7</u> |
| | T ___ R ___ | _____ |
| | T ___ R ___ | _____ |
| | T ___ R ___ | _____ |
| 2. Property Controlling in Section | S ___ T ___ R ___ | _____ |
| | S ___ T ___ R ___ | _____ |
| 3. Miscellaneous Property in Sec. | S ___ T ___ R ___ | _____ |
| | S ___ T ___ R ___ | _____ |

RECEIVED & FILED
DIANE FRANKOVICH
 MACKINAC COUNTY REGISTER OF DEEDS

NOV 15 1996
 AM _____ PM _____
 7|8|9|10|11|12|1|2|3|4|5|6

Register of Deeds Stamp & File Number

4. Lot No. _____, Recorded Plat _____

5. Private Claims _____

I, JAMES H. GRANGER, in a field survey on AUGUST 28, 19 96 do hereby state that under requirements of P.A. 74, Michigan P.A. of 1970, the corner points mentioned in lines 1 and 2 above were in conformance with regulations and rules therefore as required in the current manual of survey instructions of the United States Department of the Interior, Bureau of Land Management or by a decree of a Court of Law and /or that the corner points mentioned in lines 3, 4 and 5 above were in conformance with the rules of the Michigan Board of Land Surveyors or by a Decree of a Court of Law; established, re-established, monumented, recovered, found as expressed below:

1	A	B	C	D	E	F	G	H	I	J	K	L	M
2	6		5		4		3		2		1		
3													
4	7		8		9		10		11		12		
5													
6	18		17		16		15		14		13		
7													
8	19		20		21		22		23		24		
9													
10	30		29		28		27		26		25		
11													
12	31		32		33		34		35		36		
13													

NOTE: Not more than 2 corners, all in the same town and range, may be recorded on this certificate.

A. Description of original monument and accessories and/or subsequent restoration:

- 1849 - Original Survey Set wood post 20" Maple N80°E 17 lks
 W. Burt 18" Beech S58°W 26 lks
- 1983 - Survey Eino Saino # 7873 1/2" iron
- 1983 - LCRC Eino Saino # 7873 1/2" iron

B. Description of corner evidence found and/or method applied in restoring or reestablishing corner:


Found 5/8" iron and four scribed witnesses.

ACCEPTED BY THE MACKINAC COUNTY SURVEY PEER GROUP AS THE OFFICIAL CORNER UNDER P.A. 345 OF 1990 AT A MEETING HELD ON 8-20-96

James H. Granger

C. Description of monument for corner and accessories established to perpetuate locating the position of the corner:

- Set 5/8" x 30" rebar with Remonumentation Cap
- 6" Tri-Maple S37°E 8.26' Set tag
- 6" Maple S52°W 12.48' Set tag
- 4" Maple N05°W 16.01' Set tag
- 12" Maple N54E 10.59' Set tag

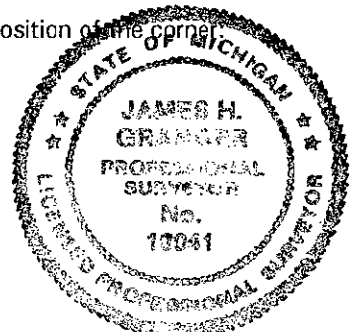

Signed by James H. Granger
 Surveyor's Michigan License No. 16041

Date 10-10-96