SURVEY & REMONUMENTATION

MAY 2 0 1997

COMMISSION

MACKINAC COUNTY REMONUMENTATION CORNER

LAND CORNER RECORDATION CERTIFICATE
Filing Requirement of Act 74, Mich. P.A. 1970

For corners in
MACKINAC
(County)

RECEIVED & FILED
DIANE FRANKOVICH
MACKINAC COUNTY REGISTER OF DEEDS
NOV 1 5 1996
AM PM
7|8|9|10|11|12|1|2|3|4|5|6

Register of Deeds Stamp & File Number

		Located In:	Corner Code #
1. Public Land Survey		T 44N R 12W	K-6
		T___ R___	
		T___ R___	
		T___ R___	
2. Property Controlling	S___	T___ R___	
in Section	S___	T___ R___	
3. Miscellaneous	S___	T___ R___	
Property in Sec.	S___	T___ R___	

4. Lot No. _____ , Recorded Plat _____

5. Private Claims _____

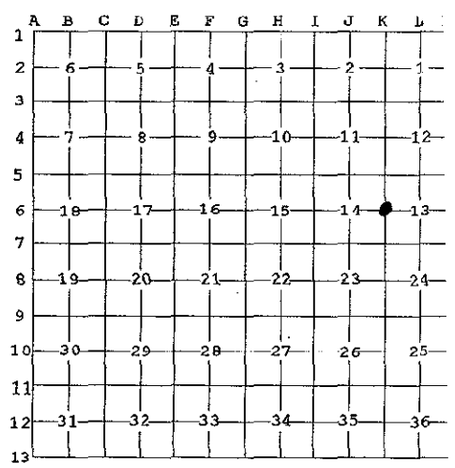

I, JAMES H. GRANGER, in a field survey on AUGUST 28, 19 96 do hereby state that under requirements of P.A. 74, Michigan P.A. of 1970, the corner points mentioned in lines 1 and 2 above were in conformance with regulations and rules therefore as required in the current manual of survey instructions of the United States Department of the Interior, Bureau of Land Management or by a decree of a Court of Law and /or that the corner points mentioned in lines 3, 4 and 5 above were in conformance with the rules of the Michigan Board of Land Surveyors or by a Decree of a Court of Law; established, re-established, monumented, recovered, found as expressed below:

NOTE: Not more than 2 corners, all in the same town and range, may be recorded on this certificate.

A. Description of original monument and accessories and/or subsequent restoration:

1849 - Original Survey — Set wood post — 8" Beech N69°E 32 lks; 5" Beech S87°W 12 lks
W. Burt

1972 - Subdivision
Eino Saino # 7873

1978 - LCRC
Thomas Kelley # 24599 — 3/4" pipe

1978 - Survey
John McMahon # 4018

1982 - Survey — 3/4" pipe
Eino Saino # 7873

1990 - Survey — 1" pipe
Thomas O'Brien # 21274

ACCEPTED BY THE MACKINAC COUNTY SURVEY PEER GROUP AS THE OFFICIAL CORNER UNDER P.A. 345 OF 1990 AT A MEETING HELD ON 8-20-96

B. Description of corner evidence found and/or method applied in restoring or reestablishing corner: James H Granger

Found 1/2" iron in Monument Box with cap #31591 and one witness.

C. Description of monument for corner and accessories established to perpetuate locating the position of the corner:

Set 5/8" x 30" rebar with Remonumenation Cap in Monument box

Power Pole	S80°E	31.85'	Set tag
Power pole	S21°E	70.64'	Set tag
Anchor Pole	N82°W	60.79'	Set tag
6" Maple	S68°W	46.73'	Fd. tag #24599

STATE OF MICHIGAN
JAMES H. GRANGER
PROFESSIONAL SURVEYOR
No. 16041
LICENSED PROFESSIONAL SURVEYOR

Signed by James H Granger — Date 10-10-96

Surveyor's Michigan License No. 16041

FORM APPROVED BY MICHIGAN STATE BOARD OF PROFESSIONAL SURVEYORS, JAN. 28, 1971
REVISED MAY 14, 1975
REVISED JAN., 1983
REVISED OCT., 1995

E 0119