SURVEYS & REMONUMENTATION

MAY 20 1997

COMMISSION

MACKINAC COUNTY REMONUMENTATION CORNER

LAND CORNER RECORDATION CERTIFICATE

Filing Requirement of Act 74, Mich. P.A. 1970

For corners in MACKINAC
(County)

RECEIVED & FILED
DIANE FRANKOVICH
MACKINAC COUNTY REGISTER OF DEEDS
NOV 15 1996
AM PM
7|8|9|10|11|12|1|2|3|4|5|6

Register of Deeds Stamp & File Number

		Located In:	Corner Code #
1. Public Land Survey		T 44N R 12W	K-8
		T___ R___	
		T___ R___	
		T___ R___	
2. Property Controlling	S___	T___ R___	
in Section	S___	T___ R___	
3. Miscellaneous	S___	T___ R___	
Property in Sec.	S___	T___ R___	

4. Lot No. _____, Recorded Plat _____

5. Private Claims _____

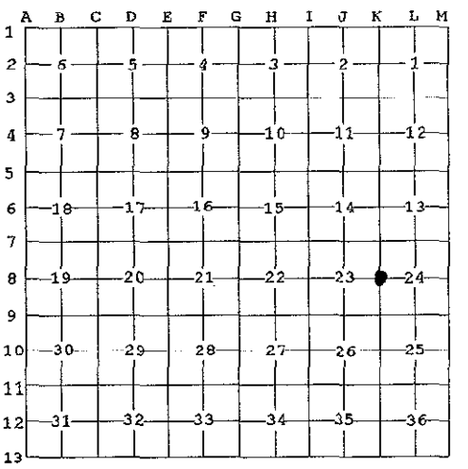

I, JAMES H. GRANGER, in a field survey on AUGUST 28, 19 96 do hereby state that under requirements of P.A. 74, Michigan P.A. of 1970, the corner points mentioned in lines 1 and 2 above were in conformance with regulations and rules therefore as required in the current manual of survey instructions of the United States Department of the Interior, Bureau of Land Management or by a decree of a Court of Law and /or that the corner points mentioned in lines 3, 4 and 5 above were in conformance with the rules of the Michigan Board of Land Surveyors or by a Decree of a Court of Law; established, re-established, monumented, *recovered, found as expressed below:*

NOTE: Not more than 2 corners, all in the same town and range, may be recorded on this certificate.

A. Description of original monument and accessories and/or subsequent restoration:

1849 - Original Survey W. Burt — Set wood post — 8" Beech N19°E 20 lks; 6" Beech S80°W 21lks

1971 - Survey Eino Siano # 7873

1992 - Survey Eino Saino # 7873

B. Description of corner evidence found and/or method applied in restoring or reestablishing corner:

Found 1" pipe.

ACCEPTED BY THE MACKINAC COUNTY SURVEY PEER GROUP AS THE OFFICIAL CORNER UNDER P.A. 345 OF 1990 AT A MEETING HELD ON 8-20-96

James H Granger

C. Description of monument for corner and accessories established to perpetuate locating the position of the corner:

Set 5/8" x 30" rebar with Remonumenation Cap

4" Elm	S41°W	39.92'	Set tag
12" Birch	N58°W	31.66'	Set tag
6" Maple	N74°E	38.45'	Set tag
4" Maple	S35°E	64.70'	Set tag

STATE OF MICHIGAN — JAMES H. GRANGER — PROFESSIONAL SURVEYOR No. 16041 — LICENSED PROFESSIONAL SURVEYOR

Signed by James H Granger

Date 10-10-96

Surveyor's Michigan License No. 16041

FORM APPROVED BY MICHIGAN STATE BOARD OF PROFESSIONAL SURVEYORS, JAN. 28, 1971
REVISED MAY 14,1975
REVISED JAN., 1983
REVISED OCT., 1995

E 0121