

MACKINAC COUNTY REMONUMENTATION CORNER

MAY 20 1997

LAND CORNER RECORDATION CERTIFICATE
Filing Requirement of Act 74, Mich. P.A. 1970

For corners in **COMMISSION**
MACKINAC

	Located In:	Corner Code #
(County)		
1. Public Land Survey	T <u>44N</u> R <u>12W</u>	<u>M-6</u>
	T _____ R _____	_____
	T _____ R _____	_____
	T _____ R _____	_____
2. Property Controlling in Section	S _____ T _____ R _____	_____
	S _____ T _____ R _____	_____
3. Miscellaneous Property in Sec.	S _____ T _____ R _____	_____
	S _____ T _____ R _____	_____

RECEIVED & FILED
DIANE FRANKOVICH
 MACKINAC COUNTY REGISTER OF DEEDS

NOV 15 1996
 AM _____ PM _____
 7|8|9|10|11|12|1|2|3|4|5|6

Register of Deeds Stamp & File Number

4. Lot No. _____, Recorded Plat _____

5. Private Claims _____

I, JAMES H. GRANGER, in a field survey on August 28, 19 96 do hereby state that under requirements of P.A. 74, Michigan P.A. of 1970, the corner points mentioned in lines 1 and 2 above were in conformance with regulations and rules therefore as required in the current manual of survey instructions of the United States Department of the Interior, Bureau of Land Management or by a decree of a Court of Law and /or that the corner points mentioned in lines 3, 4 and 5 above were in conformance with the rules of the Michigan Board of Land Surveyors or by a Decree of a Court of Law; established, re-established, monumented, recovered, found as expressed below:

NOTE: Not more than 2 corners, all in the same town and range, may be recorded on this certificate.

A	B	C	D	E	F	G	H	I	J	K	L	M
1												
2	6	5	4	3	2	1						
3												
4	7	8	9	10	11	12						
5												
6	18	17	16	15	14	13						
7												
8	19	20	21	22	23	24						
9												
10	30	29	28	27	26	25						
11												
12	31	32	33	34	35	36						
13												

A. Description of original monument and accessories and/or subsequent restoration:

- | | | | | | |
|-------------------------|---------------|-------------|--------------|-------------------------|-----------|
| 1849 - Original Survey | Set wood post | 10" Sugar | N46°E 29 lks | 1975 - Survey | iron pipe |
| W. Burt | | 18" Hemlock | N51°W 23 lks | Franklyn Burgess # 2531 | |
| 1957 - Subdivision | | | | 1978 - LCRC | iron pipe |
| Franklyn Burgess # 2531 | | | | John McMahon # 4018 | |
| 1957 - Subdivision | | | | 1978 - Survey | iron pipe |
| | | | | John McMahon # 4018 | |
| 1971 - Survey | iron pipe | | | 1980 - Survey | 1/2" iron |
| Franklyn Burgess # 2531 | | | | Thomas O'Brien # 21274 | |
| | | | | 1990 - Survey | 1/2" iron |
| | | | | Thomas O'Brien # 21274 | |

B. Description of corner evidence found and/or method applied in restoring or reestablishing corner:

Found 5/8" iron.

ACCEPTED BY THE MACKINAC COUNTY
 SURVEY PEER GROUP AS THE
 OFFICIAL CORNER UNDER P.A.
 345 OF 1990 AT A MEETING
 HELD ON 8-29-96


James H. Granger

C. Description of monument for corner and accessories established to perpetuate locating the position of the corner:

Also corner A-6, T44N, R11W

Placed Remonumentation Cap on iron in Monument box

- | | | | |
|-------------------|-------|--------|---------|
| Concrete Monument | EAST | 33.00' | |
| Anchor Pole | N41°E | 59.80' | Set tag |
| House Corner | S63°W | 56.99' | |
| Power Pole | N30°W | 64.84' | Set tag |

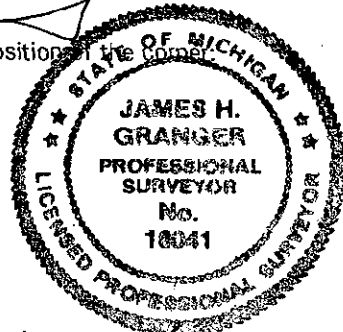

Signed by James H. Granger
 Surveyor's Michigan License No. 16041

Date 10-10-96