

MACKINAC COUNTY REMONUMENTATION CORNER

MAY 20 1997

LAND CORNER RECORDATION CERTIFICATE  
Filing Requirement of Act 74, Mich. P.A. 1970

COMMISSION

For corners in  
MACKINAC

(County)	Located In:	Corner Code #
1. Public Land Survey	T <u>44N</u> R <u>12W</u>	<u>M-11</u>
	T _____ R _____	_____
	T _____ R _____	_____
	T _____ R _____	_____
2. Property Controlling in Section	S _____ T _____ R _____	_____
	S _____ T _____ R _____	_____
3. Miscellaneous Property in Sec.	S _____ T _____ R _____	_____
	S _____ T _____ R _____	_____

RECEIVED & FILED  
DIANE FRANKOVICH  
MACKINAC COUNTY REGISTER OF DEEDS

NOV 15 1996  
AM \_\_\_\_\_ PM \_\_\_\_\_  
7|8|9|10|11|12|1|2|3|4|5|6

Register of Deeds Stamp & File Number

4. Lot No. \_\_\_\_\_, Recorded Plat \_\_\_\_\_

5. Private Claims \_\_\_\_\_

I, JAMES H. GRANGER, in a field survey on AUGUST 29, 19 96, do hereby state that under requirements of P.A. 74, Michigan P.A. of 1970, the corner points mentioned in lines 1 and 2 above were in conformance with regulations and rules therefore as required in the current manual of survey instructions of the United States Department of the Interior, Bureau of Land Management or by a decree of a Court of Law and for that the corner points mentioned in lines 3, 4 and 5 above were in conformance with the rules of the Michigan Board of Land Surveyors or by a Decree of a Court of Law; established, re-established, monumented, recovered, found as expressed below:

NOTE: Not more than 2 corners, all in the same town and range, may be recorded on this certificate.

A	B	C	D	E	F	G	H	I	J	K	L	M
1												
2	6		5		4		3		2		1	
3												
4	7		8		9		10		11		12	
5												
6	18		17		16		15		14		13	
7												
8	19		20		21		22		23		24	
9												
10	30		29		28		27		26		25	
11												
12	31		32		33		34		35		36	
13												

A. Description of original monument and accessories and/or subsequent restoration:

- 1841 - Original Survey W. Burt Set wood post 9" Sugar N12°E 14 lks 16" Lynn N07°W 41 lks
- 1979 - Survey Thomas O'Brien # 21274 set iron bar

ACCEPTED BY THE MACKINAC COUNTY SURVEY PEER GROUP AS THE OFFICIAL CORNER UNDER P.A. 345 OF 1990 AT A MEETING HELD ON 8-20-96

*James H. Granger*

B. Description of corner evidence found and/or method applied in restoring or reestablishing corner:


Found 1/2" iron with cap # 31591 and two witnesses.

C. Description of monument for corner and accessories established to perpetuate locating the position of the corner:

also corner A-11, T44n, R11W

Set 5/8" X 30" rebar with Remonumentation Cap

- 5' Balsam N62°W 72.58' Fd. tag #31591
- 10" Maple S54°W 64.00' Fd. tag #31591
- Power Pole N71°E 40.81' Set tag
- Fence Post S50°E 44.85' Set tag

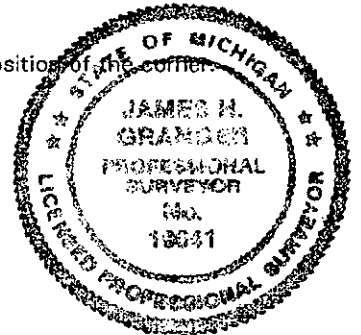

Signed by James H. Granger  
Surveyor's Michigan License No. 16041

Date 10-10-96