

MAY 20 1997

MACKINAC COUNTY REMONUMENTATION CORNER

LAND CORNER RECORDATION CERTIFICATE  
Filing Requirement of Act 74, Mich. P.A. 1970

For corners in  
MACKINAC

Located In: Corner Code #

(County)

- 1. Public Land Survey T 44N R 12W Corner Code # M-12  
T \_\_\_\_\_ R \_\_\_\_\_  
T \_\_\_\_\_ R \_\_\_\_\_  
T \_\_\_\_\_ R \_\_\_\_\_
- 2. Property Controlling S \_\_\_\_\_ T \_\_\_\_\_ R \_\_\_\_\_  
in Section S \_\_\_\_\_ T \_\_\_\_\_ R \_\_\_\_\_
- 3. Miscellaneous S \_\_\_\_\_ T \_\_\_\_\_ R \_\_\_\_\_  
Property in Sec. S \_\_\_\_\_ T \_\_\_\_\_ R \_\_\_\_\_

RECEIVED & FILED  
DIANE FRANKOVICH  
MACKINAC COUNTY REGISTER OF DEEDS

NOV 15 1996  
AM \_\_\_\_\_ PM \_\_\_\_\_  
7|8|9|10|11|12|1|2|3|4|5|6

Register of Deeds Stamp & File Number

4. Lot No. \_\_\_\_\_, Recorded Plat \_\_\_\_\_

5. Private Claims \_\_\_\_\_

I, JAMES H. GRANGER, in a field survey on AUGUST 28, 19 96  
do hereby state that under requirements of P.A. 74, Michigan P.A. of 1970, the corner points  
mentioned in lines 1 and 2 above were in conformance with regulations and rules therefore as  
required in the current manual of survey instructions of the United States Department of the Interior,  
Bureau of Land Management or by a decree of a Court of Law and /or that the corner points  
mentioned in lines 3, 4 and 5 above were in conformance with the rules of the Michigan Board of  
Land Surveyors or by a Decree of a Court of Law; established, re-established, monumented,  
recovered, found as expressed below:

NOTE: Not more than 2 corners, all in the same town and range, may be recorded  
on this certificate.

1	A	B	C	D	E	F	G	H	I	J	K	L	M
2		6		5		4		3		2		1	
3													
4		7		8		9		10		11		12	
5													
6		18		17		16		15		14		13	
7													
8		19		20		21		22		23		24	
9													
10		30		29		28		27		26		25	
11													
12		31		32		33		34		35		36	
13													

A. Description of original monument and accessories and/or subsequent restoration:

1841 - Original Survey Set wood post 8" Tamarack N12°E 14 lks  
W. Burt 4" Tamarack N82°W 17 lks

B. Description of corner evidence found and/or method applied in restoring or reestablishing corner:

Found 1/2" iron with cap # 31591 and three Fabis witnesses.

ACCEPTED BY THE MACKINAC COUNTY  
SURVEY PEER GROUP AS THE  
OFFICIAL CORNER UNDER P.A.  
345 OF 1990 AT A MEETING  
HELD ON 8-20-96


*James H. Granger*

C. Description of monument for corner and accessories established to perpetuate locating the position of

also corner **A-12, T44N, R11W**

Set 5/8" X 30" rebar with Remonumentation Cap in Monument box

- 10' Tamarack N85°W 43.34' Fd. tag #31591
- 6" Cedar S60°W 50.30' Fd. tag #31591
- 5" Cedar N45°W 68.08' Fd. tag #31591
- 10" Tamarack S83°W 64.11' Set tag

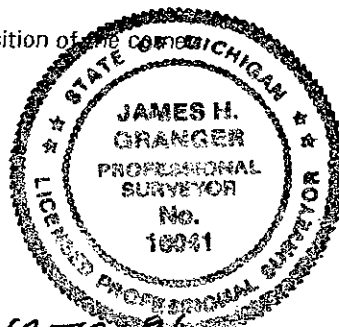

Signed by James H. Granger

Date 10-20-96

Surveyor's Michigan License No. 16041