SURVEY & REMONUMENTATION

MAY 20 1997

COMMISSION

MACKINAC COUNTY REMONUMENTATION CORNER

LAND CORNER RECORDATION CERTIFICATE
Filing Requirement of Act 74, Mich. P.A. 1970

For corners in MACKINAC
(County)

RECEIVED & FILED
DIANE FRANKOVICH
MACKINAC COUNTY REGISTER OF DEEDS
NOV 15 1996
AM PM
7|8|9|10|11|12|1|2|3|4|5|6

Register of Deeds Stamp & File Number

		Located In:	Corner Code #
1. Public Land Survey		T 44N R 12W	M-13
		T____ R____	
		T____ R____	
		T____ R____	
2. Property Controlling	S____	T____ R____	
in Section	S____	T____ R____	
3. Miscellaneous	S____	T____ R____	
Property in Sec.	S____	T____ R____	

4. Lot No. _____ , Recorded Plat _____

5. Private Claims _____

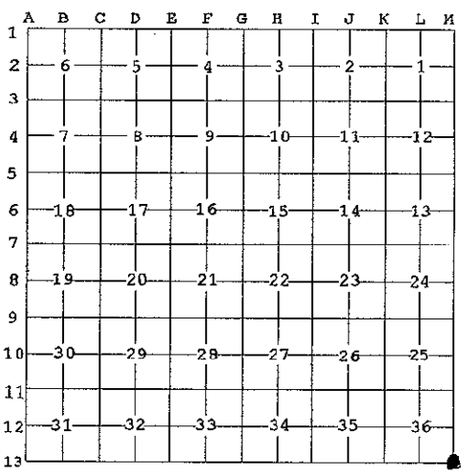

I, JAMES H. GRANGER, in a field survey on AUGUST 28, 19 96 do hereby state that under requirements of P.A. 74, Michigan P.A. of 1970, the corner points mentioned in lines 1 and 2 above were in conformance with regulations and rules therefore as required in the current manual of survey instructions of the United States Department of the Interior, Bureau of Land Management or by a decree of a Court of Law and /or that the corner points mentioned in lines 3, 4 and 5 above were in conformance with the rules of the Michigan Board of Land Surveyors or by a Decree of a Court of Law; established, re-established, monumented, recovered, found as expressed below:

NOTE: Not more than 2 corners, all in the same town and range, may be recorded on this certificate.

A. Description of original monument and accessories and/or subsequent restoration:

1841 - Original Survey — Set wood post
W. Burt

1986 - LCRC
Gerald Wiggins

ACCEPTED BY THE MACKINAC COUNTY SURVEY PEER GROUP AS THE OFFICIAL CORNER UNDER P.A. 345 OF 1990 AT A MEETING HELD ON 8-20-96

James H Granger

B. Description of corner evidence found and/or method applied in restoring or reestablishing corner:

Found pk nail set by Fabis # 31591and three Fabris witnesses.

STATE OF MICHIGAN
JAMES H. GRANGER
PROFESSIONAL SURVEYOR
No. 16041
LICENSED PROFESSIONAL SURVEYOR

C. Description of monument for corner and accessories established to perpetuate locating the position of the corner:

Set 5/8" X 30" rebar with Remonumentation Cap in Monument box

12" Tamarack	N31°W	72.06'	Set tag
Power Pole	S50°E	71.98'	Fd. tag #31591
5" Cedar	S47°W	96.15'	Fd. tag #13591
7" Cedar	N72°W	66.64'	Fd. tag #31591

also corner M-1, T43N, R12W
also corner A-1, T43N, R11W
also corner A-13, T44N, R11W

Signed by James H Granger Date 10-10-96

Surveyor's Michigan License No. 16041

FORM APPROVED BY MICHIGAN STATE BOARD OF PROFESSIONAL SURVEYORS, JAN. 28, 1971
REVISED MAY 14,1975
REVISED JAN., 1983
REVISED OCT., 1995

E 0107