

LAND CORNER RECORDATION CERTIFICATE  
 Filing Requirement of Act 74, Mich. P.A. 1970

For corners in

<u>Macomb</u> (County)	Located In: Warren Township	Corner Code #
1. Public Land Survey	T <u>1N</u> R <u>12E</u>	<u>A-2</u>
	T <u>   </u> R <u>   </u>	<u>   </u>
	T <u>   </u> R <u>   </u>	<u>   </u>
	T <u>   </u> R <u>   </u>	<u>   </u>
2. Property Controlling in Section	S <u>   </u> T <u>   </u> R <u>   </u>	<u>   </u>
	S <u>   </u> T <u>   </u> R <u>   </u>	<u>   </u>
3. Miscellaneous Property in Sec.	S <u>   </u> T <u>   </u> R <u>   </u>	<u>   </u>
	S <u>   </u> T <u>   </u> R <u>   </u>	<u>   </u>

SURVEY &  
 REMONUMENTATION

APR 07 1998

SECTION

Register of Deeds Stamp & File Number

4. Lot No. \_\_\_\_\_, Recorded Plat \_\_\_\_\_  
 5. Private Claims \_\_\_\_\_

I, Huston K. Kennedy, in a field survey on 7/29, 1997 do hereby state that under requirements of P.A. 74, Michigan P.A. of 1970, the corner points mentioned in lines 1 and 2 above were in conformance with regulations and rules therefore as required in the current manual of survey instructions of the United States Department of the Interior, Bureau of Land Management or by a decree of a Court of Law and/or that the corner points mentioned in lines 3, 4 and 5 above were in conformance with the rules of the Michigan Board of Land Surveyors or by a Decree of a Court of Law; established, re-established, monumented, recovered, found as expressed below:

NOTE: Not more than 2 corners, all in the same town and range, may be recorded on this certificate.

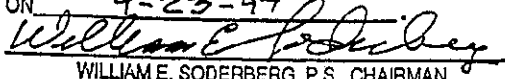
	A	B	C	D	E	F	G	H	I	J	K	L	M
1													
2	6		5		4		3		2		1		
3													
4	7		8		9		10		11		12		
5													
6	18		17		16		15		14		13		
7													
8	19		20		21		22		23		24		
9													
10	30		29		28		27		26		25		
11													
12	31		32		33		34		35		36		
13													

A. Description of original monument and accessories and/or subsequent restoration:  
 1817-GLO Wanpler, D.S.; No post was set

B. Description of corner evidence found and/or method applied in restoring or reestablishing corner:  
 1997 Kennedy Surveying, Inc. - Kennedy, PS #17623 - Fnd 3/4" Iron Rod in a Monument Box in the center of the left turn lane of Dequindre Road extending to the North & South, which has a concrete surface. The East 1/4 corner of Section 1, T1N, R11E, Royal Oak Township (M-2) is located 3.03 feet to the South.

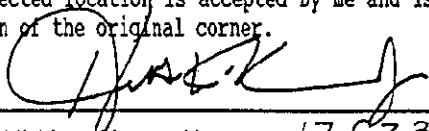
I accepted the found 3/4" Iron Rod in a Monument Box.

See back side of LCRC for Field Measurements

ACCEPTED BY THE MACOMB COUNTY SURVEY PEER GROUP AS THE OFFICIAL CORNER UNDER MICHIGAN PUBLIC ACT 345 OF 1990 AT A MEETING HELD ON 9-23-97  
  
 WILLIAM E. SODERBERG, P.S., CHAIRMAN

C. Description of monument for corner and accessories established to perpetuate locating the position of the corner:  
 A-2 I replaced the found 3/4" Iron Rod with a 3/4" x 24" Iron Rod w/2" diameter aluminum cap stamped "Macomb County Monument MI Act 345" #17623 in a existing Monument Box  
 N56°W 63.09' Set PK & Remon Washer SW face Power Pole  
 N19°E 133.18' Set PK & Remon Washer NW face Power Pole  
 S45°E 64.47' Set PK & Remon Washer NE face Power Pole  
 S31°W 99.79' Set PK & Remon Washer SE face Power Pole  
 South 3.03 feet, East 1/4 corner of Section 1, T1N, R11E, Royal Oak Township (M-2)

The selected location is accepted by me and is generally accepted by Professional Surveyors as the best available location of the position of the original corner.

Signed by   
 Surveyor's Michigan License No. 17623

Date 11-12-97



736

FIELD MEASUREMENTS BETWEEN:

A-2 to A-1

No GLO  
No map or plat distances  
GROUND-MEA = 2832.43 Ft.  
GRID-MEA = 2832.21 Ft. or 2832.46 Ft. GROUND CAL.

A-2 to A-3

No GLO  
M.C.P.C. Map distance = 2638.75 Ft.  
GROUND-MEA = 2544.64 Ft.  
GRID-MEA = 2544.14 Ft. or 2544.37 Ft. GROUND CAL.

A-2 to M-2

No GLO  
GROUND-MEA = 3.03 Ft.

C0619502 LIBER:07769 PAGE:488 08:30A 12/12/1997  
CARMELLA SABAUGH-MACOMB COUNTY, MI REG/DEEDS