

LAND CORNER RECORDATION CERTIFICATE  
 Filing Requirement of Act 74, Mich. P.A. 1970

For corners in

Macomb

(County)

Located In: Warren Township

Corner Code #

- |                                    |   |    |   |     |     |
|------------------------------------|---|----|---|-----|-----|
| 1. Public Land Survey              | T | 1N | R | 12E | A-3 |
|                                    | T |    | R |     |     |
|                                    | T |    | R |     |     |
|                                    | T |    | R |     |     |
| 2. Property Controlling in Section | S |    | T |     |     |
|                                    | S |    | T |     |     |
| 3. Miscellaneous Property in Sec.  | S |    | T |     |     |
|                                    | S |    | T |     |     |

SURVEY & REMONUMENTATION

APR 07 1998

ACCEPTED BY THE MACOMB COUNTY SURVEY PEER GROUP AS THE OFFICIAL CORNER UNDER MICHIGAN PUBLIC ACT 345 OF 1990 AT A MEETING HELD ON 9-23-77

*William E. Soderberg*  
 WILLIAM E. SODERBERG, P.S., CHAIRMAN

Register of Deeds Stamp & File Number

4. Lot No. \_\_\_\_\_, Recorded Plat \_\_\_\_\_  
 5. Private Claims \_\_\_\_\_

I, Huston K. Kennedy, in a field survey on 7-29, 1997 do hereby state that under requirements of P.A. 74, Michigan P.A. of 1970, the corner points mentioned in lines 1 and 2 above were in conformance with regulations and rules therefore as required in the current manual of survey instructions of the United States Department of the Interior, Bureau of Land Management or by a decree of a Court of Law and for that the corner points mentioned in lines 3, 4 and 5 above were in conformance with the rules of the Michigan Board of Land Surveyors or by a Decree of a Court of Law; established, re-established, monumented, recovered, found as expressed below:

NOTE: Not more than 2 corners, all in the same town and range, may be recorded on this certificate.

1	A	B	C	D	E	F	G	H	I	J	K	L	M
2		6		5		4		3		2		1	
3													
4		7		8		9		10		11		12	
5													
6		18		17		16		15		14		13	
7													
8		19		20		21		22		23		24	
9													
10		30		29		28		27		26		25	
11													
12		31		32		33		34		35		36	
13													

A. Description of original monument and accessories and/or subsequent restoration:  
 1817-GLO Wampler, D.S.; Set Post 6" Ash N36°W 15 Links; 6" Ash S34°E 5 Links

B. Description of corner evidence found and/or method applied in restoring or reestablishing corner:  
 1997 Kennedy Surveying, Inc. - Kennedy, PS #17623 - The corner as recovered is 11.00 feet South of the existing center of the West bound lane of 13 Mile, extending to the East & West, which has a concrete surface, and in the existing center of Dequindre Road extending to the North & South, which has a concrete surface. Corner common to Sections 1 & 12, T1N, R11E, Royal Oak Township (M-3) is located 105.81 feet to the South.

HOW THE CORNER WAS RECOVERED

I recovered the corner based upon the existing monumentation along the West and South lines of "SUPERVISOR'S PLAT OF EYSTER-HARTSIG DEQUINDRE FARMS", Liber 23, page 19 of Macomb County Records. I used the existing monumentation along the West and North lines "SUPERVISOR'S PLAT OF EYSTER-CROMINE DEQUINDRE FARMS", Liber 23, page 39 of Macomb County Records were used to verify the recovered position of the corner, which was within 0.29 feet.

C. Description of monument for corner and accessories established to perpetuate locating the position of the corner:


- A-3 I set a 3/4" x 24" Iron Rod w/2" diameter aluminum cap stamped "Macomb County Monument MI Act 345" #17623 in a new-Monument Box  
 S15°W 181.88' Cut "x" on top bolt on Fire Hydrant  
 S39°E 78.20' Cut "x" on top bolt on Fire Hydrant  
 N62°W 87.11' Set PK & Remon Washer SW face Power Pole  
 N43°E 67.40' Set PK & Remon Washer NW face Power Pole  
 Due South 105.81 feet, corner common to Sections 1 & 12, T1N, R11E, Royal Oak Township (M-3)

See back side of LCRC for Field Measurements

The selected location is accepted by me and is generally accepted by Professional Surveyors as the best available evidence of position of the original corner.

Signed by *H. Kennedy*  
 Surveyor's Michigan License No. 176230

Date 11-12-97

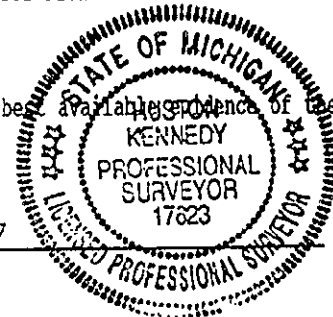

FIELD MEASUREMENTS BETWEEN

A-3 to A-2

No GLO

M.C.P.C. Map = 2632.75 Ft.

GROUND-MEA = 2544.37 Ft.

GRID-MEA = 2544.14 Ft. or 2544.37 Ft. GROUND CAL.

A-3 to A-4

No GLO

M.C.P.C. Map = 2706.73 Ft.

"EYSTER-CROMIE DEQUINDRE FARMS" + "BARBARY SUBDIVISION" + Parcels = 2706.73 Ft.

GRID-MEA = 2707.83 Ft. or 2708.07 Ft. GROUND CAL.

A-3 to M-3

GLO = 153 links or 100.98 Ft.

GROUND-MEA = 105.81 Ft.

C0619501 LIBER:07769 PAGE:486 08:30A 12/12/1997  
CARMELLA SABAUGH-MACOMB COUNTY, MI REG/DEEDS