


**LAND CORNER RECORDATION CERTIFICATE**  
**Filing Requirement of Act 74, Mich. P.A. 1970**

For corners in

<u>MACOMB</u> (County)	Located In: <u>WARREN</u>	Corner Code # <u>        </u>
1. Public Land Survey	T <u>1N</u> R <u>12E</u>	<u>A-5</u>
	T <u>    </u> R <u>    </u>	<u>        </u>
2. Property Controlling in Section	S <u>    </u> T <u>    </u> R <u>    </u>	<u>        </u>
	S <u>    </u> T <u>    </u> R <u>    </u>	<u>        </u>
3. Miscellaneous Property in Sec.	S <u>    </u> T <u>    </u> R <u>    </u>	<u>        </u>
	S <u>    </u> T <u>    </u> R <u>    </u>	<u>        </u>
4. Lot No. <u>        </u> , Recorded Plat <u>        </u>		
5. Private Claims <u>        </u>		

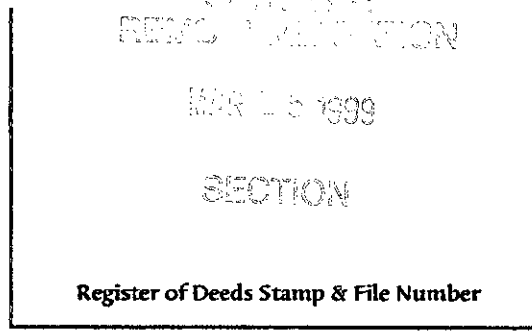

I, STEVEN E. DUNN, in a field survey on JUNE 6, 1998, do hereby certify that under requirements of P.A. 74, Michigan P.A. of 1970, the corner points mentioned in lines 1 and 2 above were in conformance with regulations and rules therefore as required in the current manual of survey instructions of the United States Department of the Interior, Bureau of Land Management or by a decree of a Court of Law and /or that the corner points mentioned in lines 3, 4 and 5 above were in conformance with the rules of the Michigan Board of Land Surveyors or by a Decree of a Court of Law, established, re-established, monumented, re-monumented, recovered, found as expressed below:

**NOTE: Not more than 2 corners, all in the same town and range, may be recorded on this certificate.**

A. Description of original monument and accessories and/or subsequent restoration:

A	B	C	D	E	F	G	H	I	J	K	L	M
2	6	5	4	3	2	1						
3												
4	7	8	9	10	11	12						
5												
6	18	17	16	15	14	13						
7												
8	19	20	21	22	23	24						
9												
10	30	29	28	27	26	25						
11												
12	31	32	33	34	35	36						
13												

GLO POST-NO EVIDENCE OF ORIGINAL CORNER FOUND. GLO SURVEY PERFORMED BY JOSEPH FLETCHER-1816 PLATS

L.91, P.7 (O.C.R.)	BEAUTY BUILT MANOR SUB.	MAY 24, 1957
L.94, P.31 (O.C.R.)	MADISON OAKS SUB.	MAR. 31, 1958
L.94, P.34 (O.C.R.)	STEVEN HEIGHTS SUB.	APR. 3, 1958
L.48, P.20-22	WILDWOOD PARK SUB.	FEB. 9, 1961
L.50, P.12	GREENBRIAR ESTATES SUB.	MAY 4, 1962
L.80, P.45 & 46	ST. LOUISE SUB.	AUG. 13, 1996
L.C.R.C.:		
L.17933, P.109(O.C.R.)	JOSEPH C. KAPELCZAK #24598	JAN. 2, 1998
	SET OAKLAND COUNTY REMONUMENTATION BRASS CAP	

B. Description of corner evidence found and/or method applied in restoring or reestablishing corner:

A-5 SECTION CORNER. CORNER IS COMMON WITH M-5, TOWN 1 NORTH, RANGE 11 EAST, OAKLAND COUNTY.

FOUND BRASS CAP STAMPED "OAKLAND COUNTY REMONUMENTATION CORNER #24598" IN A MONUMENT BOX IN ASPHALT CAPPED CONCRETE PAVEMENT AT THE CENTERLINE INTERSECTION OF DEQUINDRE AND 12 MILE ROAD.

I VERIFIED THE LOCATION BY COMPARING MEASURED DISTANCES AND ANGLES TO RECORDED DISTANCES AND ANGLES OF ITEMS LISTED ABOVE. CORNER ALSO MATCH THE WITNESS TIES OF ABOVE L.C.R.C.

FIELD MEASUREMENTS AND RECORD MEASUREMENTS:

A-5 TO A-6	A-5 TO A-4	A-5 TO B-5
2640.00' (GLO 40 CHAINS)	2640.00' (GLO 40 CHAINS)	2640.00' (GLO 40 CHAINS)
2630.56' FIELD	2699.49' FIELD	2277.50' ST. LOUISE SUB.
		2235.94' WILDWOOD PARK
		2237.56' FIELD

L.C.R.C. L.17933, P. 109  
 S.42°W. 98.66'  
 N.58°W. 73.35'

CHISELED "+" IN NE BOLT LEG OF SIGN POST.  
 CHISELED "+" IN SE BOLT STREET LIGHT BASE.

C. Description of monument for corner and accessories established to perpetuate locating the position of the corner:

A-5 SECTION CORNER

I ACCEPTED THE LOCATION OF THE FOUND OAKLAND COUNTY REMONUMENTATION BRASS DISK AS THE CORNER. BRASS CAP ON 3/4" IRON ROD STAMPED "OAKLAND COUNTY REMONUMENTATION #24508" IN A MONUMENT BOX.

WITNESSES:

N.40°E. 65.19'	FOUND PK NAIL NW FACE UTILITY POLE.
N.58°W. 78.61'	FOUND PK W/MCRC TAG SE FACE UTILITY POLE.
N.60°W. 73.30'	FOUND "+" CUT IN SE BOLT LIGHT POLE BASE.
S.40°W. 98.74'	FOUND "+" CUT IN NE BOLT LEG OF SIGN POST.
S.54°E. 81.07'	FOUND "+" CUT IN NW BOLT LIGHT POLE BASE.

ACCEPTED BY THE MACOMB COUNTY SURVEY PEER GROUP AS THE OFFICIAL CORNER UNDER MICHIGAN PUBLIC ACT 345 OF 1990 AT A MEETING HELD ON 9/29/98

*William E. Soderberg*  
 WILLIAM E. SODERBERG, P.S., CHAIRMAN



THE SELECTED LOCATION IS ACCEPTED BY ME AND IS GENERALLY ACCEPTED BY PROFESSIONAL SURVEYORS AS THE BEST AVAILABLE EVIDENCE OF THE POSITION OF THE ORIGINAL CORNER.

Signed by Steven E. Dunn Date Sept. 29, 1998  
 Surveyor's Michigan License No. 28408

FORM APPROVED BY MICHIGAN STATE BOARD OF LAND SURVEYORS, JAN. 26, 1971  
 REVISED MAY 14, 1976  
 REVISED JAN., 1983

809