

**SURVEY & REMONUMENTATION**

APR 29 1996

C0254804 LIBER:06772 PAGE:406 08:56A 09/26/1995  
 CARMELLA SABAUGH-MACOMB COUNTY, MI REG/DEEDS

COMMISSION

**LAND CORNER RECORDATION CERTIFICATE**  
 Filing Requirement of Act 74, Mich. P.A. 1970

For corners in

<u>MACOMB</u> (County)	Located In: <u>WARREN</u>	Corner Code # <u>H-1</u>
1. Public Land Survey	T <u>1N</u> R <u>12E</u>	<u>H-1</u>
	T _____ R _____	_____
	T _____ R _____	_____
	T _____ R _____	_____
2. Property Controlling in Section	S _____ T _____ R _____	_____
	S _____ T _____ R _____	_____
3. Miscellaneous Property in Sec.	S _____ T _____ R _____	_____
	S _____ T _____ R _____	_____
4. Lot No. _____, Recorded Plat _____		
5. Private Claims _____		

Register of Deeds Stamp & File Number

	A	B	C	D	E	F	G	H	I	J	K	L	M
2	6	5	4	3	2	1							
3													
4	7	8	9	10	11	12							
6													
6	18	17	16	15	14	13							
7													
8	19	20	21	22	23	24							
9													
10	30	29	28	27	26	25							
11													
12	31	32	33	34	35	36							
13													

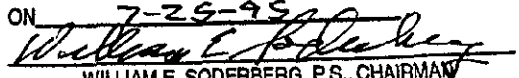
I, STEVEN E. DUNN, in a field survey on MARCH 09, 19 95, do hereby certify that under requirements of P.A. 74, Michigan P.A. of 1970, the corner points mentioned in lines 1 and 2 above were in conformance with regulations and rules therefore as required in the current manual of survey instructions of the United States Department of the Interior, Bureau of Land Management or by a decree of a Court of Law and /or that the corner points mentioned in lines 3, 4 and 5 above were in conformance with the rules of the Michigan Board of Land Surveyors or by a Decree of a Court of Law; established, re-established, monumented, re-monumented, recovered, found as expressed below:

**NOTE: Not more than 4 corners, all in the same town and range, may be recorded on this certificate.**

A. Description of original monument and accessories and/or subsequent restoration:

NO ORIGINAL CORNER SET.

- |   |  |  |
|---|--|--|
| <u>PLAT</u><br>L. 9, P. 51 & 52<br><u>M.D.O.T. RIGHT - OF - WAY MAP</u><br>M - 53 (VAN DYKE) SHEET NO. 53<br>M.C.R.C. WITNESS CARD (UNRECORDED)<br><u>L.C.R.C.</u><br>L. 6416, P. 845<br>M.C.R.C. | TREMBLETON SUB.<br>JULY 8, 1925<br>HARRY H. KEMNITZ #16931<br>14 MILE RD. CONSTRUCTION PLANS SHEET NO. 6 | MONUMENT BOX FOUND<br>AUG. 8, 1994<br>1974 |
|   | G. RANDALL 1/4 "ROD IN ASPHALT RD.   | JULY 6, 1973                               |

ACCEPTED BY THE MACOMB COUNTY SURVEY PEER GROUP AS THE OFFICIAL CORNER UNDER MICHIGAN PUBLIC ACT 345 OF 1990 AT A MEETING HELD ON 7-29-95  
  
 WILLIAM E. SODERBERG, P.S., CHAIRMAN

B. Description of corner evidence found and/or method applied in restoring or reestablishing corner:  
 H-1 1/4 CORNER

FOUND 1/2" IRON IN MONUMENT BOX IN CONCRETE PAVEMENT. FOUND CORNER MATCHES DOCUMENTATION LISTED ABOVE, BUT IS 2.64' SOUTH OF LINE H-13 AND I-13 (T. 2N., R. 12 E.) CORNER SHOULD BE ON SAID LINE.

FIELD MEASUREMENTS AND RECORDED DISTANCES  
 H-1 TO I-1 - 2844.11' M. 2829.63' (TAX DESCRIPTIONS)  
 H-1 TO H-13 (T. 2N., R. 12 E.) - 243.07' M.  
 H-1 TO G-1 2847.45' M. 2848.30' (PLATS)



C. Description of monument for corner and accessories established to perpetuate locating the position of the corner:

H-1, T.1N.,R.12E. SET 3/4" X 24" IRON ROD WITH 2" DIAMETER ALUMINUM CAP STAMPED "MACOMB COUNTY MONUMENT MI. ACT 345 #28408" IN A NEW MONUMENT BOX.

WITNESSES

- |           |         |  |
|-----------|---------|--|
| WEST      | 243.07' | FOUND 3/4" X 24" IRON ROD WITH 2" DIAMETER ALUMINUM CAP STAMPED "MACOMB COUNTY MONUMENT MI. ACT 345 #28408" IN MONUMENT BOX. |
| SOUTH     | 2.64'   | FOUND 1/2" IRON ROD IN MONUMENT BOX.   |
| N. 54° W. | 45.65'  | SET P.K. NAIL WITH M.C.R. WITNESS TAG AT TOP OF CURB.  |
| N. 53° E. | 44.42'  | SET P.K. NAIL WITH M.C.R. WITNESS TAG AT TOP OF CURB.  |
| S. 10° E. | 59.84'  | SET P.K. NAIL WITH M.C.R. WITNESS TAG AT SIDEWALK.   |
| S. 48° W. | 60.14'  | SET P.K. NAIL WITH M.C.R. WITNESS TAG IN NORTH FACE OF UTILITY POLE.   |

THE SELECTED LOCATION IS ACCEPTED BY ME AND IS GENERALLY ACCEPTED BY PROFESSIONAL SURVEYORS AS THE BEST AVAILABLE EVIDENCE OF THE POSITION OF THE CORNER

Signed by Steven E. Dunn Date Aug. 1, 1995  
 Surveyor's Michigan License No. 28408