

SURVEY & REMONUMENTATION

APR 29 1996

COMMISSION

LAND CORNER RECORDATION CERTIFICATE
Filing Requirement of Act 74, Mich. P.A. 1970

For corners in

Macomb
(County)

Located In: City of Warren Corner Code # M10

- | | | |
|------------------------------------|----------------------------|------------|
| 1. Public Land Survey | T <u>1</u> N R <u>12</u> E | <u>M10</u> |
| | T ___ R ___ | _____ |
| | T ___ R ___ | _____ |
| | T ___ R ___ | _____ |
| 2. Property Controlling in Section | S ___ T ___ R ___ | _____ |
| | S ___ T ___ R ___ | _____ |
| 3. Miscellaneous Property in Sec. | S ___ T ___ R ___ | _____ |
| | S ___ T ___ R ___ | _____ |

Register of Deeds Stamp & File Number

4. Lot No. _____, Recorded Plat _____
5. Private Claims _____

I, Craig P. Amey, in a field survey on August 7, 1995 do hereby certify that under requirements of P.A. 74, Michigan P.A. of 1970, the corner points mentioned in lines 1 and 2 above were in conformance with regulations and rules therefore as required in the current manual of survey instructions of the United States Department of the Interior, Bureau of Land Management or by a decree of a Court of Law and/or that the corner points mentioned in lines 3, 4 and 5 above were in conformance with the rules of the Michigan Board of Land Surveyors or by a Decree of a Court of Law, established, re-established, monumented, re-monumented, recovered, found as expressed below.

A	B	C	D	E	F	G	H	I	J	K	L	M
1												
2	6		5		4		3		2		1	
3												
4	7		8		9		10		11		12	
5												
6	18		17		16		15		14		13	
7												
8	19		20		21		22		23		24	
9												
10	30		29		28		27		26		25	
11												
12	31		32		33		34		35		36	
13												

NOTE: Not more than 4 corners, all in the same town and range, may be recorded on this certificate.

A. Description of original monument and accessories and/or subsequent restoration:

- | | | | |
|------|------------------------------|-----------------|---------------------|
| 1818 | GLO | William Preston | No witnesses remain |
| 1952 | Irwin Kern Manor Subdivision | L26 P39 | |
| 1955 | Douglas Heights Sub | L32 P07 | |

This corner is common to Section 30, T1N, R13E, Erin/LakeTwp. ((A10) and Section 25, T1N, R12E. (M10)

B. Description of corner evidence found and/or method applied in restoring or reestablishing corner:


No evidence of the original corner or perpetuation of the position was found. Adjacent subdivisions were used to determine the location of the corner. The E/W quarter line of section 30 was established from property irons found in "Irwin Kern Manor Subdivision". The W line of section 30 was established from property irons found in "Douglas Heights Sub". The lines were intersected, matching the tie distance to the monument found in "Irwin Kern Manor Subdivision". The location also matches the intersection of the physical centerline of Stephens Road and Hayes Road.

C. Description of monument for corner and accessories established to perpetuate locating the position of the corner:

- | | |
|-----------------|---|
| | SET A 3/4" X 24" IRON WITH MCR CAP #34970 IN A NEW MONUMENT BOX |
| AZ 78° 72.65' | Set PK nail and MCR tag in the northwest face of a guy pole |
| AZ 162° 109.03' | Southwest corner of a brick house #15006 |
| AZ 225° 36.90' | Set PK nail and MCR tag in the northwest face of a utility pole |
| AZ 330° 47.73' | Set PK nail and MCR tag in the southwest face of a utility pole |

The selected location is accepted by me and is generally accepted by professional surveyors as the best available evidence of the position of the original corner.

ACCEPTED BY THE MACOMB COUNTY SURVEY PEER GROUP AS THE OFFICIAL CORNER UNDER MICHIGAN PUBLIC ACT 345 OF 1990 AT A MEETING HELD ON 8-15-95
William E. Soderberg
WILLIAM E. SODERBERG, P.S., CHAIRMAN

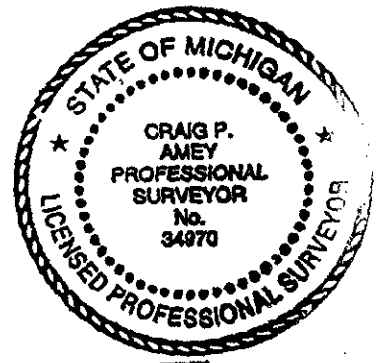

Signed by C. Amey
Surveyor's Michigan License No. 34970

Date 12-15-95

FORM APPROVED BY MICHIGAN STATE BOARD OF LAND SURVEYORS, JAN. 28, 1971
REVISED MAY 14, 1975
REVISED JAN., 1983