


SURVEY &  
REMONUMENTATION

NOV 06 1998

SECTION

Erir Township T1N, R13E

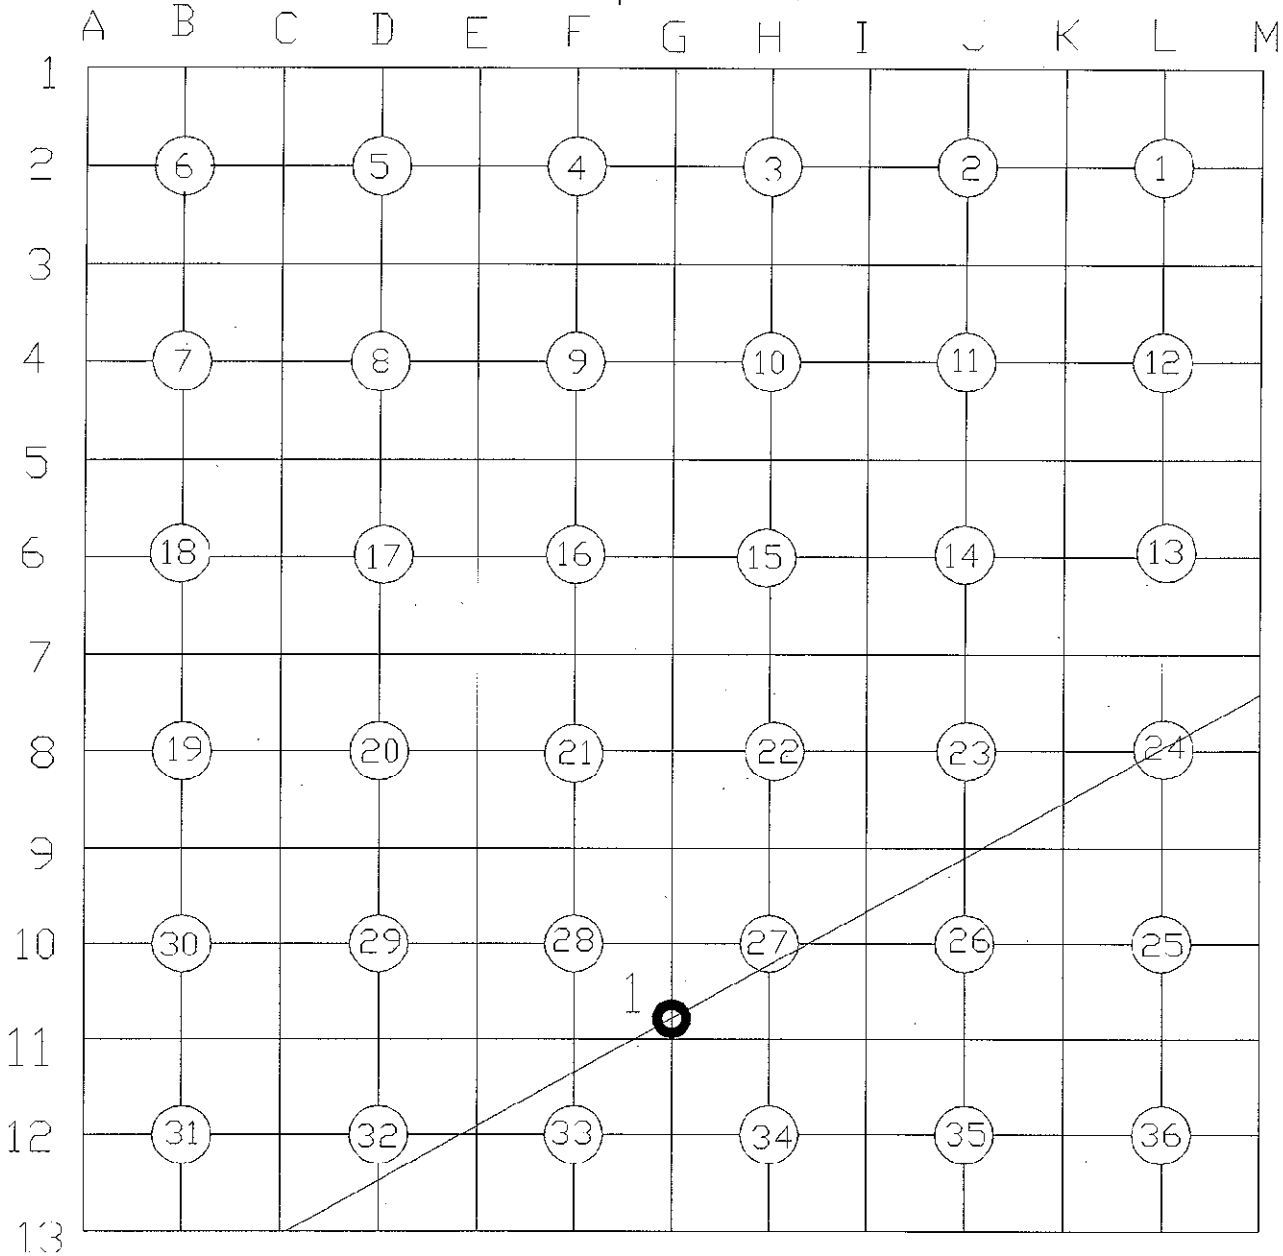

1 = INTERSECTION OF G LINE AND NW LINE OF PC 599  
RECORDED LIBFR 6862 PAGE 845 RECORD 802