


Erin Township T1N, R13E

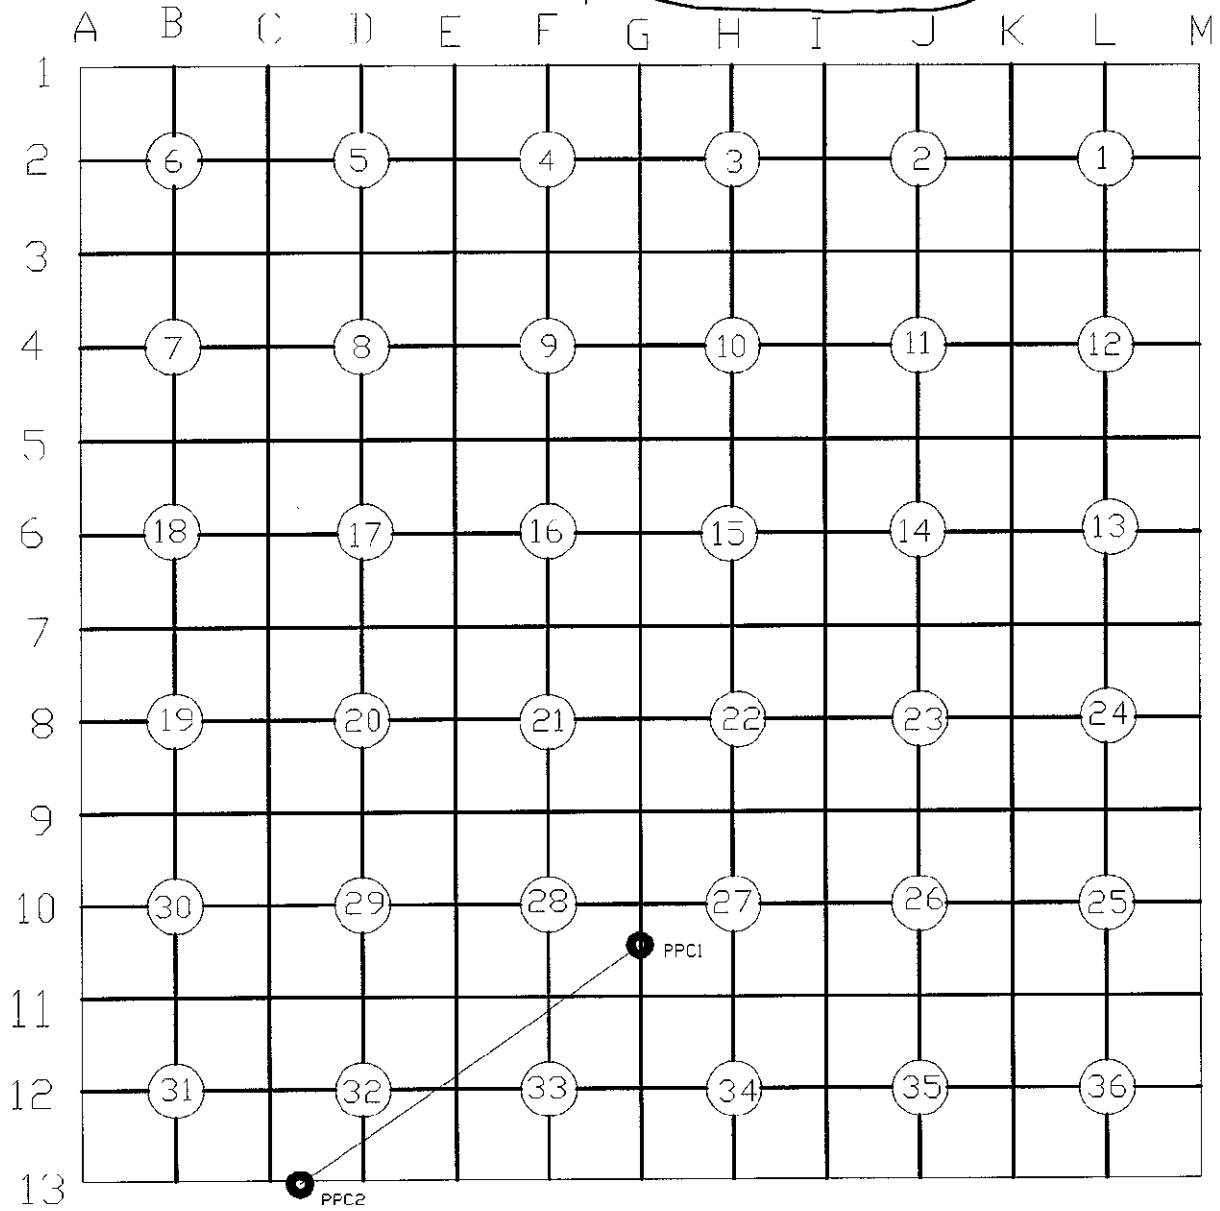

SURVEY &  
REMONUMENTATION

MAR 17 2000

SECTION