


**LAND CORNER RECORDATION CERTIFICATE**  
**Filing Requirement of Act 74, Mich. P.A. 1970**

For corners in

<u>MACOMB</u> (County)	Located In: ERIN / LAKE	Corner Code #
1. Public Land Survey	T <u>1N</u> R <u>13E</u>	<u>A-4</u>
	T <u>   </u> R <u>   </u>	<u>   </u>
	T <u>   </u> R <u>   </u>	<u>   </u>
	T <u>   </u> R <u>   </u>	<u>   </u>
2. Property Controlling in Section	S <u>   </u> T <u>   </u> R <u>   </u>	<u>   </u>
	S <u>   </u> T <u>   </u> R <u>   </u>	<u>   </u>
3. Miscellaneous Property in Sec.	S <u>   </u> T <u>   </u> R <u>   </u>	<u>   </u>
	S <u>   </u> T <u>   </u> R <u>   </u>	<u>   </u>
4. Lot No. _____, Recorded Plat _____		
5. Private Claims _____		

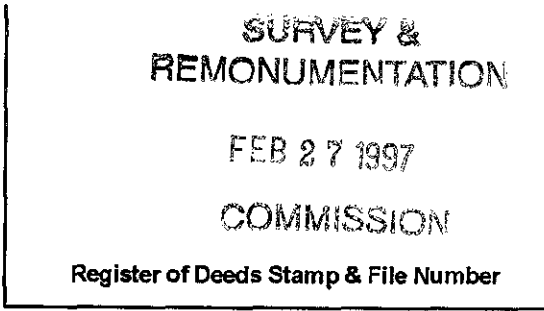

A	B	C	D	E	F	G	H	I	J	K	L	M
2	6	5	4	3	2	1						
3												
4	7	8	9	10	11	12						
5												
6	18	17	16	15	14	13						
7												
8	19	20	21	22	23	24						
9												
10	30	29	28	27	26	25						
11												
12	31	32	33	34	35	36						
13												

I, STEVEN E. DUNN, in a field survey on MARCH 29, 19 96, do hereby certify that under requirements of P.A. 74, Michigan P.A. of 1970, the corner points mentioned in lines 1 and 2 above were in conformance with regulations and rules therefore as required in the current manual of survey instructions of the United States Department of the Interior, Bureau of Land Management or by a decree of a Court of Law and/or that the corner points mentioned in lines 3, 4 and 5 above were in conformance with the rules of the Michigan Board of Land Surveyors or by a Decree of a Court of Law, established, re-established, monumented, re-monumented, recovered, found as expressed below:

**NOTE: Not more than 2 corners, all in the same town and range, may be recorded on this certificate.**

A. Description of original monument and accessories and/or subsequent restoration:

**GLO POST - NO EVIDENCE OF ORIGINAL CORNERS FOUND ORIGINAL SURVEY PREFORMED BY PRESTON IN 1818**

**PLATS:**  
 VENETIAN VILLAGE GROVE L.41,P.35-38 MAY 14, 1958  
 WEST GROVE SUBDIVISION L.43, P.39-41 APRIL 3, 1959  
 LORETO SUBDIVISION L.45,P.57 DECEMBER 1, 1959

*C0458183 LIBER:07298 PAGE:216 10:47A 01/02/1997  
 CARMELLA SABAUGH-MACOMB COUNTY, MI REG/DEEDS*



B. Description of corner evidence found and/or method applied in restoring or reestablishing corner:

A-4 1/4 CORNER COMMON TO M-4 T.1N., R.12E.

**FOUND 1/2" IRON ROD IN CONCRETE PAVEMENT (NO MON. BOX). VERIFIED LOCATION BY COMPARING MEASURED DISTANCES AND ANGLES TO RECORDED DISTANCES AND ANGLES.**

**FIELD MEASUREMENTS AND RECORDED DISTANCES**

ANGLE A-3/A-4/B-4	89°49'02" M.	90°05'25" R.	(WEST GROVE SUB)		
ANGLE B-4/A-4/A-5	90°02'36" M.				
A-4 TO A-3	2710.81' M.	2711.63' R.	(WEST GROVE SUB)	40 CHAINS	(G.L.O. 2640.00)
A-4 TO B-4	2710.30' M.	2710.60' R.	(WEST GROVE SUB. & LORETO SUB.)	40 CHAINS	(G.L.O. 2640.00)
A-4 TO A-5	2683.81' M.				

ACCEPTED BY THE MACOMB COUNTY SURVEY PEER GROUP AS THE OFFICIAL CORNER UNDER MICHIGAN PUBLIC ACT 345 OF 1990 AT A MEETING HELD ON 8-20-94.

*William E. Soderberg*  
 WILLIAM E. SODERBERG, P.S., CHAIRMAN

C. Description of monument for corner and accessories established to perpetuate locating the position of the corner:

A-4 T.1N.,R.13E.

**I REPLACED 1/2" IRON ROD WITH A 3/4" IRON ROD WITH 2" DIAMETER ALUMINUM CAP STAMPED "MACOMB COUNTY MONUMENT, MI ACT 345 #28408" IN A NEW MONUMENT BOX.**

**WITNESSES**

N.61°E. 63.01'	FOUND P.K. NAIL IN NW FACE UTILITY POLE
S.56°E. 70.18'	FOUND P.K. NAIL IN SW FACE UTILITY POLE
S.28°W. 106.41'	FOUND P.K. NAIL IN WEST FACE UTILITY POLE
S.52°W. 63.15'	SCRIBED "+" IN SOUTH RIM STORM MANHOLE
N.48°W. 53.68'	SET MAG NAIL W/MACOMB COUNTY REMONUMENTATION WITNESS TAG IN NW FACE UTILITY POLE
N.47°W. 51.14'	FOUND PK NAIL W/MACOMB COUNTY REMONUMENTATION WITNESS TAG IN NE FACE UTILITY POLE

**THE SELECTED LOCATION IS ACCEPTED BY ME AND IS GENERALLY ACCEPTED BY PROFESSIONAL SURVEYORS AS THE BEST AVAILABLE EVIDENCE OF THE POSITION OF THE CORNER**

Signed by Steven E. Dunn Date Sep. 19, 1996  
 Surveyor's Michigan License No. 28408

592