

# SURVEY & REMONUMENTATION

APR 29 1996

## COMMISSION LAND CORNER RECORDATION CERTIFICATE Filing Requirement of Act 74, Mich. P.A. 1970

For corners in

Macomb	Located In:	Corner Code #D3
(County)	Erin/Lake Township	
1. Public Land Survey	T <u>1N</u> R <u>13E</u>	<u>D3</u>
	T <u>   </u> R <u>   </u>	<u>   </u>
	T <u>   </u> R <u>   </u>	<u>   </u>
	T <u>   </u> R <u>   </u>	<u>   </u>
2. Property Controlling in Section	S <u>   </u> T <u>   </u> R <u>   </u>	<u>   </u>
	S <u>   </u> T <u>   </u> R <u>   </u>	<u>   </u>
3. Miscellaneous Property in Sec.	S <u>   </u> T <u>   </u> R <u>   </u>	<u>   </u>
	S <u>   </u> T <u>   </u> R <u>   </u>	<u>   </u>

ACCEPTED BY THE MACOMB COUNTY SURVEY PEER GROUP AS THE OFFICIAL CORNER UNDER MICHIGAN PUBLIC ACT 345 OF 1990 AT A MEETING HELD ON 8-15-95  
*William E. Soderberg*  
WILLIAM E. SODERBERG, P.S., CHAIRMAN

Register of Deeds Stamp & File Number

4. Lot No. \_\_\_\_\_, Recorded Plat \_\_\_\_\_  
5. Private Claims \_\_\_\_\_

I, Craig P. Amey, in a field survey on August 7, 1995 do hereby certify that under requirements of P.A. 74, Michigan P.A. of 1970, the corner points mentioned in lines 1 and 2 above were in conformance with regulations and rules therefore as required in the current manual of survey instructions of the United States Department of the Interior, Bureau of Land Management or by a decree of a Court of Law and for that the corner points mentioned in lines 3, 4 and 5 above were in conformance with the rules of the Michigan Board of Land Surveyors or by a Decree of a Court of Law; established, re-established, monumented, re-monumented, recovered, found as expressed below:

A	B	C	D	E	F	G	H	I	J	K	L	M
1												
2	6		5		4		3		2		1	
3			●									
4	7		8		9		10		11		12	
5												
6	18		17		16		15		14		13	
7												
8	19		20		21		22		23		24	
9												
10	30		29		28		27		26		25	
11												
12	31		32		33		34		35		36	
13												

**NOTE: Not more than 4 corners, all in the same town and range, may be recorded on this certificate.**

A. Description of original monument and accessories and/or subsequent restoration:

1818	GLO		William Preston	No witnesses remain
1987	LCRC	L4241 P429	Daniel Sandomierski	Found 1/2" iron pipe in mon box
1994	Cert. of Survey		Raymond J. Donnelly	Found 1" pipe in mon box

B. Description of corner evidence found and/or method applied in restoring or reestablishing corner:


Found 1" pipe in mon box in the centerline of 13 Mile Road (concrete)

This corner verified by:

Witnesses from LCRC L4241 P429  
N26°E 103.75 Southeast corner of church  
S56°W 85.35 Top of hydrant

Witnesses from Cert. of Survey, Raymond J. Donnelly  
232° 85.33 Centerline of a hydrant

W 2726.60 Southwest corner of section 5 (C3) (GLO = 40 ch)  
E 2683.87 Southeast corner of section 5 (E3) (GLO = 40ch)

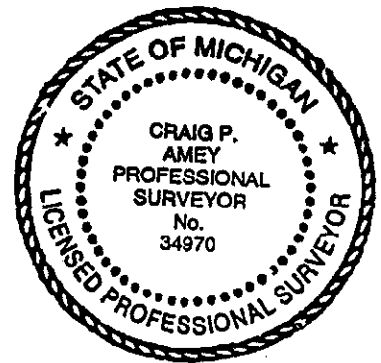

C. Description of monument for corner and accessories established to perpetuate locating the position of the corner:

REPLACED 1" PIPE WITH 3/4" X 24" IRON WITH MCR CAP #34970 IN EXISTING MONUMENT BOX  
AZ 166° 47.78 Set PK and MCR tag in W face of a utility pole  
AZ 3° 53.03 Spike with RJD tag in SW face of a utility pole  
AZ 236° 85.23 Centerline of a hydrant  
AZ 334° 103.75 Southeast corner of church

The selected location is accepted by me and is generally accepted by professional surveyors as the best available evidence of the position of the original corner.

Signed by *C.P.A.* Date 12-15-95  
Surveyor's Michigan License No. 34970

FORM APPROVED BY MICHIGAN STATE BOARD OF LAND SURVEYORS, JAN. 28, 1971

REVISED MAY 14, 1975  
REVISED JAN., 1983

C0292266 LIBER:06862 PAGE:825 11:11A 12/21/1995  
CARMELLA SABAUGH-MACOMB COUNTY, MI REG/DEEDS