

**SURVEY &  
REMONUMENTATION**

APR 29 1996

**COMMISSION LAND CORNER RECORDATION CERTIFICATE**  
Filing Requirement of Act 74, Mich. P.A. 1970

For corners in

<u>Macomb</u> (County)	Located In:	Corner Code #G7
	<u>ErinLake Township</u>	
1. Public Land Survey	T <u>1N</u> R <u>13E</u>	<u>G7</u>
	T ___ R ___	___
	T ___ R ___	___
	T ___ R ___	___
2. Property Controlling in Section	S ___ T ___ R ___	___
	S ___ T ___ R ___	___
3. Miscellaneous Property in Sec.	S ___ T ___ R ___	___
	S ___ T ___ R ___	___

4. Lot No. \_\_\_\_\_, Recorded Plat \_\_\_\_\_  
5. Private Claims \_\_\_\_\_

Register of Deeds Stamp & File Number

A	B	C	D	E	F	G	H	I	J	K	L	M
1												
2	6		5		4		3		2		1	
3												
4	7		8		9		10		11		12	
5												
6	18		17		16		15		14		13	
7												
8	19		20		21		22		23		24	
9												
10	30		29		28		27		26		25	
11												
12	31		32		33		34		35		36	
13												

I, Craig P. Amey, in a field survey on August 7, 1995 do hereby certify that under requirements of P.A. 74, Michigan P.A. of 1970, the corner points mentioned in lines 1 and 2 above were in conformance with regulations and rules therefore as required in the current manual of survey instructions of the United States Department of the Interior, Bureau of Land Management or by a decree of a Court of Law and /or that the corner points mentioned in lines 3, 4 and 5 above were in conformance with the rules of the Michigan Board of Land Surveyors or by a Decree of a Court of Law; established, re-established, monumented, re-monumented, recovered, found as expressed below:

**NOTE: Not more than 4 corners, all in the same town and range, may be recorded on this certificate.**

A. Description of original monument and accessories and/or subsequent restoration:

1818 GLO Willam Preston No witnesses remain cap #17365

B. Description of corner evidence found and/or method applied in restoring or reestablishing corner:  
Found 3/4" iron at the intersection of the physical centerlines of Little Mack Road and 11 Mile Road  
This corner verified by:

"Visanaw's Mack Avenue Little Farms Subdivision". The west line of this subdivision extends from the southwest corner of section 15 (G7) to the west quarter post of section 15 (G6). The record distance is 2697.1 feet and the measured distance is 2697.24 feet.

This corner also matches record distances to irons found on parcels along 11 mile as described in:  
Quit Claim Deed Liber 2905, P711  
Quit Claim Deed Liber 3756, P297


N 2697.24 East quarter post of section 16 (G6) (GLO = 40ch)  
S 2696.75 East quarter post of section 21 (G8) (GLO = 40ch)

C. Description of monument for corner and accessories established to perpetuate locating the position of the corner:

REPLACED IRON WITH 3/4" X 24" IRON WITH MCR CAP #34970 IN A NEW MONUMENT BOX  
AZ 43° 64.53 Top of hydrant on the northeast corner of 11 mile and Little Mack  
AZ 140° 71.10 Set PK nail and MCR tag in the northeast face of a traffic light pole  
AZ 230° 73.63 Set PK nail and MCR tag in the southeast face of a traffic light pole  
AZ 306° 61.56 Set PK nail and MCR tag in the southwest face of a traffic light pole

The selected location is accepted by me and is generally accepted by professional surveyors as the best available evidence of the position of the original corner.

ACCEPTED BY THE MACOMB COUNTY SURVEY PEER GROUP AS THE OFFICIAL CORNER UNDER MICHIGAN PUBLIC ACT 345 OF 1990 AT A MEETING HELD ON 8-15-95  
William E. Soderberg  
WILLIAM E. SODERBERG, P.S., CHAIRMAN

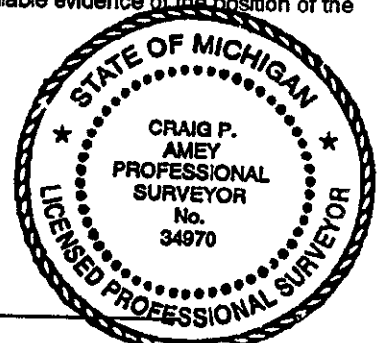

Signed by C.P.A. Date 12-15-95  
Surveyor's Michigan License No. 34970

FORM APPROVED BY MICHIGAN STATE BOARD OF LAND SURVEYORS, JAN. 28, 1971