

**SURVEY &
REMONUMENTATION**

APR 29 1996

COMMISSION LAND CORNER RECORDATION CERTIFICATE
Filing Requirement of Act 74, Mich. P.A. 1970

For corners in

Macomb Located In: ErinLake Township Corner Code #G9
(County)

- | | | |
|------------------------------------|--------------------------|-----------|
| 1. Public Land Survey | T <u>1N</u> R <u>13E</u> | <u>G9</u> |
| | T ___ R ___ | _____ |
| | T ___ R ___ | _____ |
| | T ___ R ___ | _____ |
| 2. Property Controlling in Section | S ___ T ___ R ___ | _____ |
| | S ___ T ___ R ___ | _____ |
| 3. Miscellaneous Property in Sec. | S ___ T ___ R ___ | _____ |
| | S ___ T ___ R ___ | _____ |

Register of Deeds Stamp & File Number

4. Lot No. _____, Recorded Plat _____
5. Private Claims _____

I, Craig P. Amey, in a field survey on August 8, 1995 do hereby certify that under requirements of P.A. 74, Michigan P.A. of 1970, the corner points mentioned in lines 1 and 2 above were in conformance with regulations and rules therefore as required in the current manual of survey instructions of the United States Department of the Interior, Bureau of Land Management or by a decree of a Court of Law and for that the corner points mentioned in lines 3, 4 and 5 above were in conformance with the rules of the Michigan Board of Land Surveyors or by a Decree of a Court of Law; established, re-established, monumented, re-monumented, recovered, found as expressed below:

NOTE: Not more than 4 corners, all in the same town and range, may be recorded on this certificate.

A	B	C	D	E	F	G	H	I	J	K	L	M
1												
2	6		5		4		3		2		1	
3												
4	7		8		9		10		11		12	
5												
6	18		17		16		15		14		13	
7												
8	19		20		21		22		23		24	
9												
10	30		29		28		27		26		25	
11												
12	31		32		33		34		35		36	
13												

A. Description of original monument and accessories and/or subsequent restoration:
1818 GLO Wooden post Willam Preston No witnesses remain


B. Description of corner evidence found and/or method applied in restoring or reestablishing corner:
Found PK nail in the intersection of the physical centerlines of Little Mack Road and 10 Mile Road. During excavation of Little Mack Road, an iron pipe of the type commonly used for surveys in this area was found 0.40' east of the PK nail. Further excavation beneath revealed the bottom portion of a wooden stake, encased in moist clay, 0.40' south of the iron pipe. The stake was approximately one foot long and squared and burnt like an original corner stake. Due to the proximity of the stake and the appearance of the stake, I believe it is the original post. The post was removed, before continued excavation of Little Mack Road and replaced with a 1/2" iron with cap #34970 at a depth of 2.5' below the existing pavement.

- N 2695.91 East quarter post of section 21 (G8) (GLO = 40ch)
- S 2713.86 East quarter post of section 28 (G10) (GLO = 40ch)

C. Description of monument for corner and accessories established to perpetuate locating the position of the corner:
SET A 3/4" X 24" IRON WITH MCR CAP #34970 IN A NEW MONUMENT BOX
AZ 40° 73.57 Found PK nail and MSHD tag in the northwest face of a utility pole
AZ 154° 74.93 Chiseled "X" in the north edge of a MBT manhole at the intersection of walks
AZ 235° 72.91 Chiseled "X" in the north edge of a sanitary manhole rim in walk
AZ 320° 65.35 Chiseled "X" in the north edge of a DE manhole

The selected location is accepted by me and is generally accepted by professional surveyors as the best available evidence of the position of the original corner.

ACCEPTED BY THE MACOMB COUNTY SURVEY PEER GROUP AS THE OFFICIAL CORNER UNDER MICHIGAN PUBLIC ACT 345 OF 1990 AT A MEETING HELD ON 8-15-95
William E. Soderberg
WILLIAM E. SODERBERG, P.S., CHAIRMAN

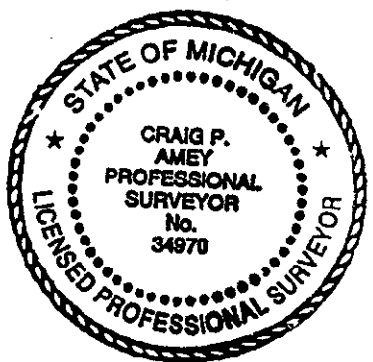

Signed by *C. P. Amey* Date 12-15-95
Surveyor's Michigan License No. 34970

FORM APPROVED BY MICHIGAN STATE BOARD OF LAND SURVEYORS, JAN. 28, 1971