

# SURVEY & REMONUMENTATION

APR 29 1996

COMMISSION

## LAND CORNER RECORDATION CERTIFICATE Filing Requirement of Act 74, Mich. P.A. 1970

For corners in

Macomb Located In: Erin/Lake Township Corner Code #G10  
(County)

- |                                    |         |                          |  |            |
|------------------------------------|---------|--------------------------|--|------------|
| 1. Public Land Survey              |         | T <u>1N</u> R <u>13E</u> |  | <u>G10</u> |
|                                    |         | T _____ R _____          |  | _____      |
|                                    |         | T _____ R _____          |  | _____      |
|                                    |         | T _____ R _____          |  | _____      |
| 2. Property Controlling in Section | S _____ | T _____ R _____          |  | _____      |
|                                    | S _____ | T _____ R _____          |  | _____      |
| 3. Miscellaneous Property in Sec.  | S _____ | T _____ R _____          |  | _____      |
|                                    | S _____ | T _____ R _____          |  | _____      |

4. Lot No. \_\_\_\_\_, Recorded Plat \_\_\_\_\_  
5. Private Claims \_\_\_\_\_

I, Craig P. Amey, in a field survey on August 8, 1995 do hereby certify that under requirements of P.A. 74, Michigan P.A. of 1970, the corner points mentioned in lines 1 and 2 above were in conformance with regulations and rules therefore as required in the current manual of survey instructions of the United States Department of the Interior, Bureau of Land Management or by a decree of a Court of Law and /or that the corner points mentioned in lines 3, 4 and 5 above were in conformance with the rules of the Michigan Board of Land Surveyors or by a Decree of a Court of Law; established, re-established, monumented, re-monumented, recovered, found as expressed below:

**NOTE: Not more than 4 corners, all in the same town and range, may be recorded on this certificate.**

Register of Deeds Stamp & File Number

	A	B	C	D	E	F	G	H	I	J	K	L	M
1													
2	6			5			4			3		2	1
3													
4	7			8			9			10		11	12
5													
6	18			17			16			15		14	13
7													
8	19			20			21			22		23	24
9													
10	30			29			28	●		27		26	25
11													
12	31			32			33			34		35	36
13													

A. Description of original monument and accessories and/or subsequent restoration:

1818 GLO William Preston No witnesses remain

B. Description of corner evidence found and/or method applied in restoring or reestablishing corner:

Found PK nail in the intersection of the physical centerlines of Little Mack Road and Stephens Road

This corner verified by:

"Dyer Subdivision", as recorded in Liber 11, Page 11, Macomb County Records. The east line of this subdivision is coincident with a portion of the line extending from the west quarter post of section 7 (G10) and the intersection of the "G" line and PC 599. The record distance is 1690.41 feet. The measured distance is 1689.42 feet.

"Assessor's Plat No. 73", as recorded in Liber 47, Page 29, Macomb County Records.

The record angle subtended by Stephens and Little Mack Road is 89°40'05". The measured angle is 89°37'54"


- N 2713.86 Northeast corner of section 28 (G9) (GLO = 40ch)
- S 1689.37 Intersection of "G" line and PC 599 (No GLO distance of record)

C. Description of monument for corner and accessories established to perpetuate locating the position of the corner:

- REPLACED PK WITH 3/4" X 24" IRON WITH MCR CAP #34970 IN A NEW MONUMENT BOX
- AZ 74° 88.61 Found PK nail and MCR tag in the southeast face of a utility pole
- AZ 129° 51.86 Chiseled "X" in the base of a steel guy pole
- AZ 310° 54.34 Found PK nail and MCR tag in the north face of a utility pole
- AZ 252° 90.42 Northerly corner of a brick building (U-Haul)

The selected location is accepted by me and is generally accepted by professional surveyors as the best available evidence of the position of the original corner.

ACCEPTED BY THE MACOMB COUNTY SURVEY PEER GROUP AS THE OFFICIAL CORNER UNDER MICHIGAN PUBLIC ACT 345 OF 1990 AT A MEETING HELD ON 8-15-95  
*William E. Soderberg*  
WILLIAM E. SODERBERG, P.S., CHAIRMAN

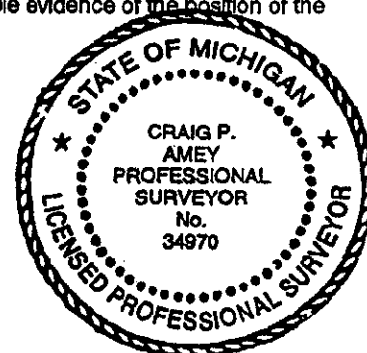

Signed by *C. Amey* Date 12.15.95  
Surveyor's Michigan License No. 34970

FORM APPROVED BY MICHIGAN STATE BOARD OF LAND SURVEYORS, JAN. 28, 1971

REVISED MAY 14, 1975  
REVISED JAN, 1983