

LAND CORNER RECORDATION CERTIFICATE  
Filing Requirement of Act 74, Mich. P.A. 1970

MAR 17 2000

For corners in

SECTION

<u>Macomb</u> (County)	Located In: Erin Twp.	Corner Code # H-01
1. Public Land Survey	T <u>1N</u> R <u>13E</u>	<u>H-01</u>
	T _____ R _____	_____
	T _____ R _____	_____
	T _____ R _____	_____
2. Property Controlling in Section	S _____ T _____ R _____	_____
	S _____ T _____ R _____	_____
3. Miscellaneous Property in Sec.	S _____ T _____ R _____	_____
	S _____ T _____ R _____	_____
4. Lot No. _____, Recorded Plat _____		
5. Private Claims _____		

1168  
LIBER 9275 PAGE 519  
01/04/2000 09:29:18 A.M.  
MACOMB COUNTY, MI  
CARNELLA SABAUGH, REG/DEEDS

Register of Deeds Stamp & File Number

I, Michael S. Hoben, in a field survey on June 18, 1999 do hereby state that under requirements of P.A. 74, Michigan P.A. of 1970, the corner points mentioned in lines 1 and 2 above were in conformance with regulations and rules therefore as required in the current manual of survey instructions of the United States Department of the Interior, Bureau of Land Management or by a decree of a Court of Law and /or that the corner points mentioned in lines 3, 4 and 5 above were in conformance with the rules of the Michigan Board of Land Surveyors or by a Decree of a Court of Law; established, re-established, monumented, recovered, found as expressed below:

NOTE: Not more than 2 corners, all in the same town and range, may be recorded on this certificate.

A	B	C	D	E	F	G	H	I	J	K	L
1											
2	6		5			4		3		2	1
3											
4	7		8			9		10		11	12
5											
6	18		17			16		15		14	13
7											
8	19		20			21		22		23	24
9											
10	30		29			28		27		26	25
11											
12	31		32			33		34		35	36
13											

A. Description of original monument and accessories and/or subsequent restoration:

H-01 1817 GLO Notes	Wampler	NA	Set Post
1958 MCRC Witnesses	NA	NA	1" Pipe
1977 MDOT plans	NA	NA	
1977 MDOT witnesses	NA	NA	FD. iron rod in mon. box
1977 LCRC L. 2872, P. 62	Douglas W. Hooth	7966	FD. 5/8" iron in mon. box
1979 LCRC L. 3818, P. 52	William E. Soderberg	17635	FD. 1/2" Re-rod in mon. box

B. Description of corner evidence found and/or method applied in restoring or reestablishing corner:

H-01 I found a 1/2" rebar in a monument box at the centerline of 14 Mile Rd. (conc.) at drive north to the cemetery. This is a common corner with H-13 T. 2 N., R. 13 E. The GLO surveyors measured south from the north line of Erin Twp.

H-13 to G-13 (R. 2704.43' 1977 MDOT) (M. 2704.50')  
The south line of Clinton Twp. by description from H-13 to I-13 (2689.14' R) (2689.55' M) (2640' R GLO)  
The north line of Erin Twp. by description from I-01 to H-01 (2689.39' R) (2689.55' M) (2640' R GLO)  
L.C.R.C. L.3818, P52 & 1958 MCRC witnesses  
NE 32.65' SE corner of brick column (32.68' M)  
NE 65.93' PK in S face of utility pole (65.81' M)  
SW 51.04' PK in NW face of twin 12" Poplar (51.07' M)  
NW 143.38' PK in S face of utility pole (143.32' M)  
NW 37.18' and 37.15' W corner of brick column (37.17' M)


ACCEPTED BY THE MACOMB COUNTY SURVEY PEER GROUP AS THE OFFICIAL CORNER UNDER MICHIGAN PUBLIC ACT 345 OF 1990 AT A MEETING HELD ON 10/26/99

*William E. Soderberg*  
WILLIAM E. SODERBERG, P.S., CHAIRMAN

C. Description of monument for corner and accessories established to perpetuate locating the position of the corner:

H-01 I placed 2" diameter aluminum cap stamped "Macomb County Monument MI Act 345 #35994 on the existing iron in an existing monument box.

N 01° E 32.62'	S.E corner 2'x2' brick drive pier W. side drive.
N 33° E 37.17'	SW corner 2'x2' brick drive pier E. side drive.
N 68° E 65.98'	Found nail w/MDSH tag NW side Power Pole.
N 68° E 65.81'	Found PK nail w/MCRC tag S. side Power Pole.
S 59° W 51.07'	Set mag nail w/Remon tag NW side twin 12" poplar.
N 72° W 143.32'	Found PK w/MCRC tag S. side Power Pole.

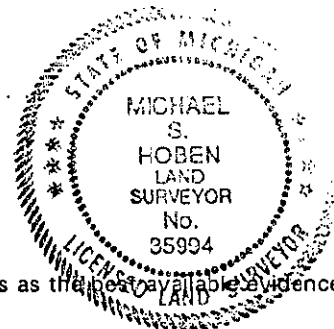

The selected location is accepted by me and is generally accepted by Professional Surveyors as the best available evidence of the original corner.

Signed by Michael S. Hoben

Date Dec 27, 1999

Surveyor's Michigan License No. 35994

FORM APPROVED BY MICHIGAN STATE BOARD OF LAND SURVEYORS, JAN. 28, 1971

REVISED MAY 14, 1988  
REVISED JAN., 1988  
REVISED OCT., 1988

937