

LAND CORNER RECORDATION CERTIFICATE
 Filing Requirement of Act 74, Mich. P.A. 1970

For corners in

<u>MACOMB</u> (County)	Located in: City of Sterling Heights	Corner Code # A-2
1. Public Land Survey	T <u>2N</u> R <u>12E</u>	<u>A-2</u>
	T _____ R _____	_____
	T _____ R _____	_____
	T _____ R _____	_____
2. Property Controlling in Section	S _____ T _____ R _____	_____
	S _____ T _____ R _____	_____
3. Miscellaneous Property in Sec.	S _____ T _____ R _____	_____
	S _____ T _____ R _____	_____
4. Lot No. _____, Recorded Plat _____		
5. Private Claims _____		

SURVEY &
 REMONUMENTATION

APR 07 1998

SECTION

Register of Deeds Stamp & File Number

I, Randy Kolehouse, in a field survey on March 5 19 97, do hereby certify that under requirements of P.A. 74 Michigan P.A. of 1970, the corner points mentioned in lines 1 and 2 above were in conformance with regulations and rules therefore as required in the current manual of survey instructions of the United States Department of the Interior, Bureau of Land Management or by a decree of a Court of Law and/or that the corner points mentioned in lines 3, 4 and 5 above were in conformance with the rules of the Michigan Board of Land Surveyors or by a Decree of a Court of Law; established, re-established, monumented, re-monumented, recovered, found as expressed below:

NOTE: Not more than 4 corners, all in the same town and range, may be recorded on this certificate.

A. Description of original monument and accessories and/or subsequent restoration:

A-2	1816	Wampler	G.L.O. Notes	Set Post
	1922	Lehner (Benz)	Field notes/description	N/A
	1976	MDSH	Road Plans - AD462	Ford Axle

(Continued on Back)

Records indicate this corner is common with M-2, T2N, R11E.

B. Description of corner evidence found and/or method applied in restoring or reestablishing corner:

A-2 Found a PK nail and RJD Tag #21563 on the C/L of Dequindre Road (bit.) running North and South on line of a tree row running East per L.C.R.C.'s L. 11062 P. 219 and L. 04854 P. 207. The found PK nail checks 60.0' East of the West right-of-way line of Dequindre Road per monumentation found in Warwick Woods Sub. (1993) and Ranieri Sub. (1974). Checks closely distances as shown in recorded plats and surveys of record. Also found an iron 4.0' West and 1.0' South of PK and tag. Held PK and Donnelly tag for M-2.

L.C.R.C. L. 11062 P. 219 (1987)
 Az 27° 166.66' PK Nail w/Tag in NW Face of U.P.
 Az 90° 42.19' PK Nail w/Tag in N Face of U.P.
 Az 180° 180.87' PK Nail w/Tag in W Face of U.P. (m. 180.82')
 Az 335° 95.09' C/L of Fire Hydrant (m. 95.02')

M.C.R.C. File
 East to Pole 42.8'
 ACCEPTED BY THE MACOMB COUNTY SURVEY PE
 GROUP AS THE OFFICIAL CORNER UNDER MICHIG
 PUBLIC ACT 345 OF 1990 AT A MEETING HE
 ON 11/14/97

William E. Soderberg
 WILLIAM E. SODERBERG, P.S., CHAIRMAN

Measure North 3446.71' to A-1 (G.L.O. = 2640.0') (Survey L. 11629 P. 330 = 3447.65' to Iron Pipe 1.0' South & 4.0' West of M-2)
 Measure South 2649.89' to A-3 (G.L.O. = 2640.0') (Warwick Woods Sub. = 2649.75')

C. Description of monument for corner and accessories established to perpetuate locating the position of the corner:

A-2 Replaced PK nail and tag with a 5/8" x 24" rebar with brass cap stamped "Oakland County Remonumentation P.S. #25854" as part of the Oakland County Remonumentation Plan. Also set a new monument box.


N 20° E 166.66' - Found PK Nail & Tag Stamped "Oakland Co. Remonumentation P.S. #25854" in NW Face Util. Pole
 N 90° E 42.19' - Found PK Nail & Tag Stamped "Oakland Co. Remonumentation P.S. #25854" in N Face Util. Pole
 S 10° E 180.82' - Found PK Nail & Tag Stamped "Oakland Co. Remonumentation P.S. #25854" in W Face Util. Pole
 N 25° W 95.02' - Found Top Ctr. Nut Hyd.

The selected location is accepted by the Contractor and is generally accepted by professional surveyors as the best available evidence of the position of the original corner.

Signed by Randy J. Kolehouse
 EARTH TECH

Date 11/14/97

Surveyor's Michigan License No. 25854

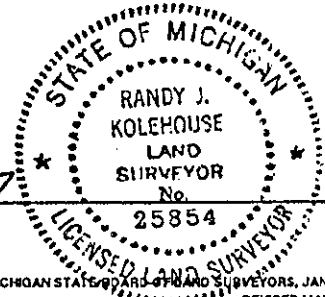

29

756

A. Description of original monument and accessories and/or subsequent restoration:

A-2	1929	Benz	Field notes/letter	N/A
	1971	Biegun	Cert. Survey L.5694 P.518	Fnd. Triangular Iron Bar
	1973	Ross	Cert. Survey L.6388 P.261	Fnd. Triangular Iron Bar
	1973	Ross	L.C.R.C. L. 7533 P. 837 (Oakland Co.)	Fnd. Triangular Iron Bar
	1974	Monohon	Ranieri Sub. L. 142 P. 25 (Oakland Co.)	N/A
	1976	Patterson	L.C.R.C. L. 2767 P. 835	N/A
	1987	Donnelly	L.C.R.C. L. 11062 P. 219 (Oakland Co.)	PK with Flasher Tag
	1990	Money	Cert. Survey L. 11629 P. 330	N/A
	1990	Patterson	L.C.R.C. L. 04854 P. 207	Iron
	1993	Patterson	Warwick Woods Sub. L. 223 P. 17 (Oakland Co.)	N/A
	N/A	N/A	O.C. Tax Maps	N/A

