

LAND CORNER RECORDATION CERTIFICATE
Filing Requirement of Act 74, Mich. P.A. 1970

corners in

<u>MACOMB</u> (County)	Located in: City of _____ Sterling Heights	Corner Code # _____
Public Land Survey	T <u>2N</u> R <u>12E</u>	<u>A-9</u>
	T _____ R _____	_____
	T _____ R _____	_____
	T _____ R _____	_____
Property Controlling in Section	S _____ T _____ R _____	_____
Miscellaneous	S _____ T _____ R _____	_____
Property in Sec.	S _____ T _____ R _____	_____


SURVEY & REMONUMENTATION

FEB 27 1997

COMMISSION

Register of Deeds Stamp & File Number

Lot No. _____, Recorded Plat _____
 Private Claims _____

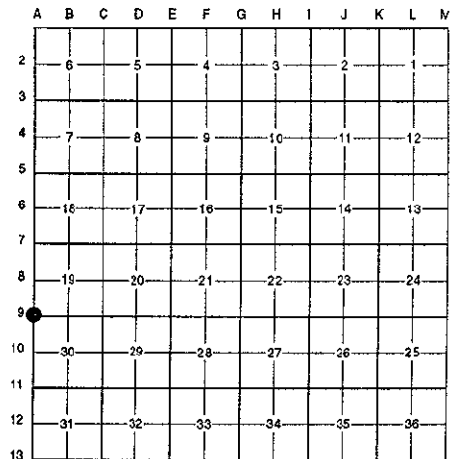

Randy Kolehouse, in a field survey on October 12 19 96,

hereby certify that under requirements of P.A. 74 Michigan P.A. of 1970, the corner points mentioned lines 1 and 2 above were in conformance with regulations and rules therefore as required in the current manual of survey instructions of the United States Department of the Interior, Bureau of Land Management or by a decree of a Court of Law and/or that the corner points mentioned in lines 3, 4 and 5 above were in conformance with the rules of the Michigan Board of Land Surveyors or by a Decree of a Court of Law; established, re-established, monumented, re-monumented, recovered, found as pressed below:

NOTE: Not more than 4 corners, all in the same town and range, may be recorded on this certificate.

Description of original monument and accessories and/or subsequent restoration:

9 Records indicate this corner is common with M-9, T2N, R11E.

1817	G.L.O. Notes	Wampler	N/A	Set Post (Oakland County T2N R11E)
1928	MCRC Wit. File	N/A	N/A	1/2" Gas Pipe
1967	MCRC Wit. File	N/A	N/A	1/2" Solid Iron in Monument Box
1986	L.C.R.C. L. 4131 P. 655	Griggs	#33511	Fnd. Monument Box
1989	L.C.R.C. L. 04800 P. 478	Wilkerson	#21584	1/2" Iron Rod

Description of corner evidence found and/or method applied in restoring or reestablishing corner:

9 I found a 1/2" rebar in a monument box at the C/L intersection of Metro Parkway running East and West and Dequindre Road running North and South. No witnesses remain from Wampler's G.L.O. notes for M-9, T2N, R11E, or the Macomb County Road Commission witnesses.

L.C.R.C. L. 4131 P. 655 (1986)
 Face of P. Pole S. 30° E. 101.9' (m. 101.74')

L.C.R.C. L. 04800 P. 478 (1989)
 N. 28° E. 120.75' - P.K. Nail in walk @ NE Cor. (m. 120.73')
 N. 25° W. 138.35' - P.K. Nail in walk @ SW Cor. (m. 138.30')

Measure South 2656.86' to A-10 (G.L.O. = 2640.0')

ACCEPTED BY THE MACOMB COUNTY SURVEY PEER GROUP AS THE OFFICIAL CORNER UNDER MICHIGAN PUBLIC ACT 345 OF 1990 AT A MEETING HELD ON


William E. Soderberg
 WILLIAM E. SODERBERG, P.S., CHAIRMAN

Description of monument for corner and accessories established to perpetuate locating the position of the corner:

9 I replaced the found 1/2" rebar with a 3/4" x 24" iron rod w/2" diameter aluminum cap stamped "Macomb County Monument MI Act 345 #25854" in an existing monument box.

- S 26° E 101.74' - Found P.K. Nail in SW Face of P. Pole
- N 28° E 120.73' - Found P.K. Nail in Walk @ NE Cor.
- N 20° W 138.30' - Found P.K. Nail in Walk @ SW Cor.
- N 40° E 113.39' - Found Center of Top of Fire Hydrant
- S 42° W 101.91' - Found P.K. & Tag No. 14864 in P. Pole
- N 28° W 111.76' - Found P.K. & Tag No. 14864 in P. Pole

The selected location is accepted by me and is generally accepted by professional surveyors as the best available evidence of the position of the original corner.

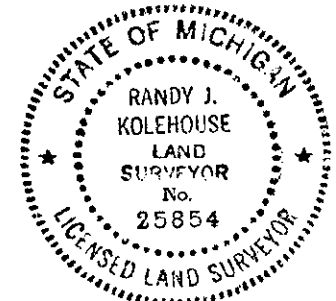

Recorded by Randy J. Kolehouse Date 11/19/96
 Surveyor's Michigan License No. 25854

633