

**SURVEY &
REMONUMENTATION**

**LAND CORNER RECORDATION CERTIFICATE
Filing Requirement of Act 74, Mich. P.A. 1970**

FEB 27 1997

COMMISSION

corners in


<u>MACOMB</u> (County)	Located in:	City of Sterling Heights	Corner Code #
Public Land Survey	T <u>2N</u>	R <u>12E</u>	<u>A-10</u>
	T _____	R _____	_____
	T _____	R _____	_____
	T _____	R _____	_____
Property Controlling in Section	S _____	T _____	R _____
Miscellaneous	S _____	T _____	R _____
Property in Sec.	S _____	T _____	R _____

ACCEPTED BY THE MACOMB COUNTY SURVEY PEER GROUP AS THE OFFICIAL CORNER UNDER MICHIGAN PUBLIC ACT 345 OF 1990 AT A MEETING HELD ON 9-17-96

William E. Soderberg
WILLIAM E. SODERBERG, P.S., CHAIRMAN

Register of Deeds Stamp & File Number

Lot No. _____, Recorded Plat _____
Private Claims _____

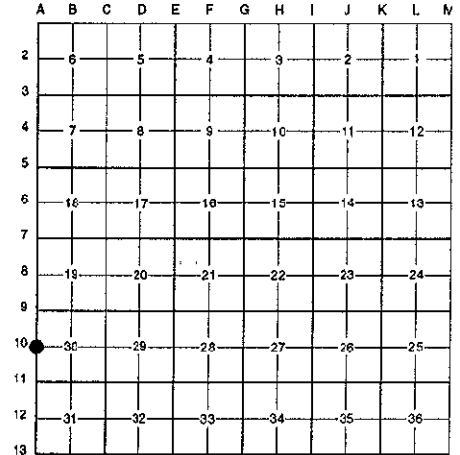

Randy Kolehouse, in a field survey on May 28 19 96, hereby certify that under requirements of P.A. 74 Michigan P.A. of 1970, the corner points mentioned lines 1 and 2 above were in conformance with regulations and rules therefore as required in the current manual of survey instructions of the United States Department of the Interior, Bureau of Land Management or by a decree of a Court of Law and/or that the corner points mentioned in lines 3, 4 and 5 above were in conformance with the rules of the Michigan Board of Land Surveyors or by a Decree of a Court of Law; established, re-established, monumented, re-monumented, recovered, found as expressed below:

NOTE: Not more than 4 corners, all in the same town and range, may be recorded on this certificate.

Description of original monument and accessories and/or subsequent restoration:

10	Records indicate this corner is common with M-10, T2N, R11E.
1817	G.L.O. Notes Wampler N/A Set Post (M-10, T2N, R11E - Oakland Co.)
1928	MCRC File No. 118 N/A N/A 1/2" Bolt in Monument Box
1967	MCRC File No. 118 N/A N/A 1/2" Solid Iron in Monument Box
1986	L.C.R.C. L. 4131 P. 655 Griggs #23511 Fnd. Monument Box
1989	L.C.R.C. L. 04800 P. 478 Wilkerson #21584 1/2" Iron Rod
1989	L.C.R.C. L. 11232 P. 627 Wilkerson #21584 1/2" Iron Rod (Oakland Co. Records)
1996	OCRC N/A N/A 1/2" Iron Rod

Description of corner evidence found and/or method applied in restoring or reestablishing corner:

10 I found a 1/2" rebar in a monument box at the C/L of Dequindre Road, 120' +/- South of the C/L of Hempstead Road, which checks with witnesses listed below. No witnesses remain from Wampler's G.L.O. notes for M-10, T2N, R11E, or from the 1928 and 1967 Macomb County Road Commission records. (Note: Dequindre Road is currently under construction.)

L.C.R.C. L. 4131 P. 655	L.C.R.C. L. 04800 P. 478
Center of fire hydrant - S 56° E - 46.0' (m. 45.98')	S. 34° W. 98.00' - Large P.K. Nail in concrete walk (m. 97.98')
Center of fire hydrant - N 25° W - 94.0' (m. 93.94')	S. 67° E. 61.59' - Large P.K. Nail in concrete walk (m. 61.52')
	S. 44° E. 82.39' - Large P.K. Nail in concrete walk (m. 82.33')
L.C.R.C. L. 11232 P. 627 (Oakland County Records)	OCRC 1996 Field Notes - Sta. 89+87.23
S. 34° W. 98.00' - Large P.K. Nail in concrete walk (m. 97.98')	S. 80° E. 42.34' - P. Pole
S. 67° E. 61.59' - Large P.K. Nail in concrete walk (m. 61.52')	S. 45° W. 78.40' - P.K. in Walk W Side Dequindre Road (m. 78.35')
S. 44° E. 82.39' - Large P.K. Nail in concrete walk (m. 82.33')	N. 45° W. 71.04' - P.K. in Walk W Side Dequindre Road (m. 70.98')

Measure South 2657.46' to A-11 (G.L.O. = 2640.0') (Hickory Heights Sub. L. 7 P. 5 = 2668.61')
Measure North 2656.86' to A-9 (G.L.O. = 2640.0')


Description of monument for corner and accessories established to perpetuate locating the position of the corner:

10 I replaced the found 1/2" rebar with a 3/4" x 24" iron rod w/2" diameter aluminum cap stamped "Macomb County Monument MI Act 345 #25854" in an existing monument box.

N 42° E 97.98' - Found P.K. Nail in Conc. Walk E Side Dequindre Road
S 89° E 42.34' - Found Doubleheaded Nail w/OCRC Tag N Face P. Pole
S 58° E 45.98' - Found Center of Top of Fire Hydrant
S 53° W 78.35' - Found P.K. Nail in Conc. Walk W Side Dequindre Road
N 23° W 93.94' - Found Center of Top of Fire Hydrant

The selected location is accepted by me and is generally accepted by professional surveyors as the best available evidence of the position of the original corner.

Witnessed by Randy J. Kolehouse Date 11/19/96
Surveyor's Michigan License No. 25854

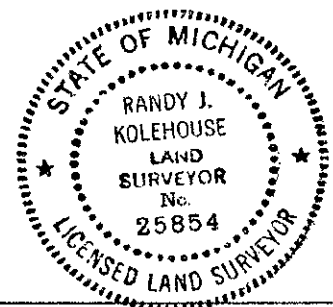

634