

**LAND CORNER RECORDATION CERTIFICATE**  
**Filing Requirement of Act 74, Mich. P.A. 1970**

corners in

MACOMB  
 (County)

Located in: City of Sterling Heights Corner Code # \_\_\_\_\_

Public Land Survey T 2N R 12E \_\_\_\_\_ A-11  
 T \_\_\_\_\_ R \_\_\_\_\_  
 T \_\_\_\_\_ R \_\_\_\_\_  
 T \_\_\_\_\_ R \_\_\_\_\_  
 Property Controlling in Section S \_\_\_\_\_ T \_\_\_\_\_ R \_\_\_\_\_  
 S \_\_\_\_\_ T \_\_\_\_\_ R \_\_\_\_\_  
 Miscellaneous S \_\_\_\_\_ T \_\_\_\_\_ R \_\_\_\_\_  
 Property in Sec. S \_\_\_\_\_ T \_\_\_\_\_ R \_\_\_\_\_


**SURVEY &  
 RE-MONUMENTATION**

FEB 27 1997

**COMMISSION**

Register of Deeds Stamp & File Number

Lot No. \_\_\_\_\_, Recorded Plat \_\_\_\_\_  
 Private Claims \_\_\_\_\_

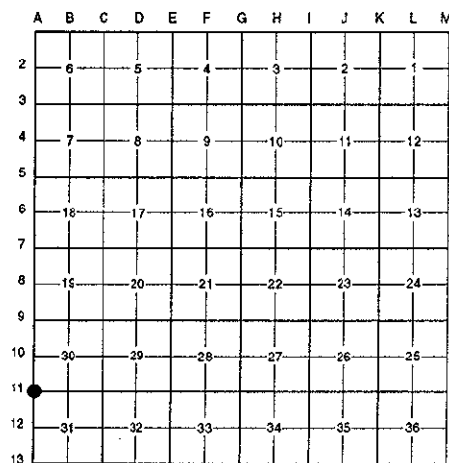

Randy Kolehouse, in a field survey on May 28 19 96,  
 hereby certify that under requirements of P.A. 74 Michigan P.A. of 1970, the corner points mentioned  
 lines 1 and 2 above were in conformance with regulations and rules therefore as required in the  
 recent manual of survey instructions of the United States Department of the Interior, Bureau of Land  
 Management or by a decree of a Court of Law and/or that the corner points mentioned in lines 3, 4 and 5  
 above were in conformance with the rules of the Michigan Board of Land Surveyors or by a Decree of a  
 Court of Law; established, re-established, monumented, re-monumented, recovered, found as  
 expressed below:

**NOTE: Not more than 4 corners, all in the same town and range, may be recorded  
 on this certificate.**

Description of original monument and accessories and/or subsequent restoration:

- |      |   |
|------|---|
| 11   | Records indicate this corner is common with M-11, T2N, R11E.                          |
| 1817 | G.L.O. Notes Wampler N/A Set Post (M-11, T2N, R11E - Oakland Co.)                     |
| 1928 | MCRC File No. 143 N/A N/A Ford Axle in Mon. Box                                       |
| 1989 | L.C.R.C. L. 04800 P. 477 Wilkerson #21584 1/2" Iron Rod                               |
| 1989 | L.C.R.C. L. 11232 P. 627 Wilkerson #21584 1/2" Iron Rod (Oakland Co. Records)         |
| 1996 | L.C.R.C. L. 16037 P. 649 Platz #38121 1/2" Iron Rod in Mon. Box (Oakland Co. Records) |

Description of corner evidence found and/or method applied in restoring or reestablishing corner:

- 11 I found a 1/2" iron rod in a monument box at the C/L of Dequindre Road (conc.) running North and South and Maple Road (15 Mile) (conc.) running East and West which checks with witnesses listed below. No witnesses remain from Wampler's G.L.O. notes for M-11, T2N, R11E, or from the 1928 Macomb County Road Commission records.

L.C.R.C. L. 04800 P. 477	L.C.R.C. L. 11232 P. 627
N. 41° W. 79.94' - P.K. Nail in conc. walk	N. 41° W. 79.94' - P.K. Nail in conc. walk
@ N.W. cor. of Maple & Dequindre.	@ N.W. cor. of Maple & Dequindre.

L.C.R.C. L. 16037 P. 649 (Oakland County Records)  
 Az. 58° 99.96'; Cut "+" on Top Nut of Fire Hydrant (m. 99.96')  
 Az. 134° 83.58'; Cut "+" on N.E. Bolt at Base of Steel Signal Pole (m. 83.54')  
 Az. 220° 80.32'; P.K. Nail w/Tag in S.E. Face of Utility Pole with Light  
 Az. 317° 83.18'; Cut "+" on N.E. Bolt at Base of Steel Signal Pole

Measure North 2657.46' to A-10 (G.L.O. = 2640.0') (Hickory Heights Sub. L. 7 P. 5 = 2668.61')  
 Measure South 2661.70' to A-12 (G.L.O. = 2640.0')


Description of monument for corner and accessories established to perpetuate locating the position of the corner:

- 11 I replaced the found 1/2" iron rod with a 3/4" x 24" iron rod w/2" diameter aluminum cap stamped "Macomb County Monument MI Act 345 #25854" in an existing monument box.

N 61° E 99.96' - Found "+" Top Nut of Fire Hydrant  
 S 43° E 83.54' - Found "+" NE Bolt Signal Pole Base  
 S 43° W 80.32' - Found P.K. Nail w/Shiner SE Face Lt. Pole  
 N 40° W 83.18' - Found "+" NE Bolt Signal Pole Base

The selected location is accepted by me and is generally accepted by professional surveyors as the best available evidence of the position of the original corner.

ACCEPTED BY THE MACOMB COUNTY SURVEY PEER GROUP AS THE OFFICIAL CORNER UNDER MICHIGAN PUBLIC ACT 345 OF 1990 AT A MEETING HELD ON 9-17-96  
  
 WILLIAM E. SODERBERG, P.S., CHAIRMAN

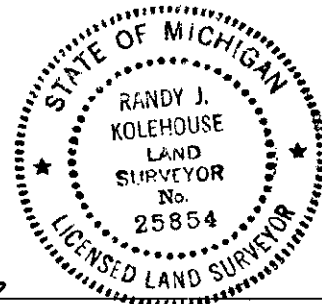

Recorded by Randy J. Kolehouse Date 11/19/96  
 Surveyor's Michigan License No. 25854