

LAND CORNER RECORDATION CERTIFICATE
Filing Requirement of Act 74, Mich. P.A. 1970

or corners in

<u>MACOMB</u> (County)	Located in:	City of Sterling Heights	Corner Code #
Public Land Survey	T <u>2N</u>	R <u>12E</u>	<u>A-12</u>
	T _____	R _____	_____
	T _____	R _____	_____
	T _____	R _____	_____
Property Controlling in Section	S _____	T _____	R _____
Miscellaneous	S _____	T _____	R _____
Property in Sec.	S _____	T _____	R _____

**SURVEY &
REMONUMENTATION**


FEB 27 1997

COMMISSION

Register of Deeds Stamp & File Number

Lot No. _____, Recorded Plat _____
Private Claims _____

Randy Kolehouse, in a field survey on May 28 19 96, hereby certify that under requirements of P.A. 74 Michigan P.A. of 1970, the corner points mentioned lines 1 and 2 above were in conformance with regulations and rules therefore as required in the present manual of survey instructions of the United States Department of the Interior, Bureau of Land Management or by a decree of a Court of Law and/or that the corner points mentioned in lines 3, 4 and 5 above were in conformance with the rules of the Michigan Board of Land Surveyors or by a Decree of a Court of Law; established, re-established, monumented, re-monumented, recovered, found as pressed below:

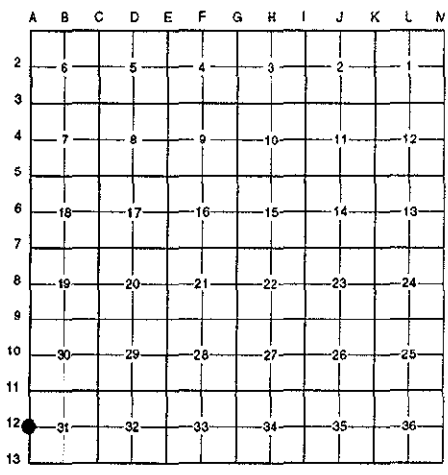

NOTE: Not more than 4 corners, all in the same town and range, may be recorded on this certificate.

Description of original monument and accessories and/or subsequent restoration:

12	Records indicate this corner is common with M-12, T2N, R11E.
1817	G.L.O. Notes Wampler N/A Set Post (M-12, T2N, R11E - Oakland Co.)
1928	MCRC File No. 144 N/A N/A 1/4" Iron in Mon. Box
1988	L.C.R.C. L. 4377 P. 553 Fenn #23505 Iron in Mon. Box
1989	L.C.R.C. L. 04800 P. 479 Wilkerson #21584 1/2" Iron Rod
1989	L.C.R.C. L. 11232 P. 626 Wilkerson #21584 1/2" Iron Rod (Oakland Co. Records)

Description of corner evidence found and/or method applied in restoring or reestablishing corner:

12 I found a 1/2" iron rod in a monument box at the C/L of Dequindre Road (conc.) running North and South which checks with witnesses listed below. No witnesses remain from Wampler's G.L.O. notes or from the 1928 Macomb County Road Commission records.

L.C.R.C. L. 4377 P. 553 East 54.63 P.K. Nail in North Face of Utility Pole (m. 54.20') Southeast 49.50 Center of G.V. & W. (m. 49.66' to C/L Storm M.H.)	L.C.R.C. L. 04800 P. 479 N. 51° E. 71.45' P.K. in conc. walk 5' ± S. of driveway to house #34020 (m. 71.20')
--	---

L.C.R.C. L. 11232 P. 626 (Oakland County Records)
N. 51° E. 71.45' P.K. in conc. walk 5' ± S. of driveway to house #34020 (m. 71.20')

ACCEPTED BY THE MACOMB COUNTY SURVEY PEER GROUP AS THE OFFICIAL CORNER UNDER MICHIGAN PUBLIC ACT 345 OF 1990 AT A MEETING HELD ON 9-17-96

WILLIAM E. SODERBERG, P.S., CHAIRMAN

Measure North 2661.70' to A-11 (G.L.O. = 2640.0')
Measure South 2668.12' to A-13 (G.L.O. = 2640.0')

Description of monument for corner and accessories established to perpetuate locating the position of the corner:


2 I replaced the found 1/2" iron rod with a 3/4" x 24" iron rod w/2" diameter aluminum cap stamped "Macomb County Monument MI Act 345 #25854" in an existing monument box.

N 42° E 85.54' - Found P.K. Nail w/Tag "OCRC" in Walk @ 34020 Dequindre
S 70° E 54.52' - Found Doubleheaded Nail w/Tag "OCRC" in N Face Lt. Pole
S 21° E 49.66' - Found "+" C/L Geodetic Monument #1993-30 in Handhole
S 44° W 72.53' - Set Nail and Macomb Co. Remon. Tag in Walk at S Side Drive to #33975 Dequindre
N 28° W 104.39' - Found P.K. Nail w/Tag "#14864" in E Face P. Pole

The selected location is accepted by me and is generally accepted by professional surveyors as the best available evidence of the position of the original corner.

Recorded by Randy J. Kolehouse
Surveyor's Michigan License No. 25854

Date 11/19/96

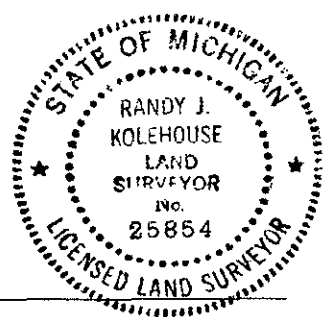

636