

# SURVEY & REMONUMENTATION

APR 28 1995

## LAND CORNER RECORDATION CERTIFICATE

Filing Requirement of Act 74, Mich. P.A. 1970

C152237

94 DEC 14 AM 10:53

For corners **COMMISSION**  
**MACOMB**

(County)

Located In: **Sterling**  
**Township** Corner Code **##**


1. Public Land Survey	T <u>2N</u>	R <u>12E</u>			B-1
	T _____	R _____			
	T _____	R _____			
	T _____	R _____			
2. Property Controlling in Section	S _____	T _____	R _____		
	S _____	T _____	R _____		
3. Miscellaneous Property in Sec.	S _____	T _____	R _____		
	S _____	T _____	R _____		

LIBER **6527** PAGE **814**

Register of Deeds Stamp & File Number

4. Lot No. \_\_\_\_\_, Recorded Plat \_\_\_\_\_  
5. Private Claims \_\_\_\_\_

I, Randy Kolehouse, in a field survey on Aug. 10, 19 94, do hereby certify that under requirements of P.A. 74, Michigan P.A. of 1970, the corner points mentioned in lines 1 and 2 above were in conformance with regulations and rules therefore as required in the current manual of survey instructions of the United States Department of the Interior, Bureau of Land Management or by a decree of a Court of Law and/or that the corner points mentioned in lines 3, 4 and 5 above were in conformance with the rules of the Michigan Board of Land Surveyors or by a Decree of a Court of Law; established, re-established, monumented, re-monumented, recovered, found as expressed below:

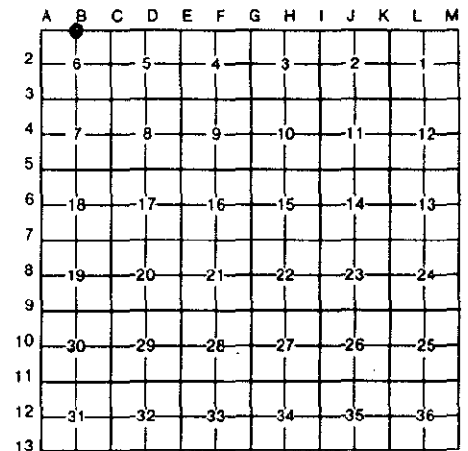

**NOTE: Not more than 4 corners, all in the same town and range, may be recorded on this certificate.**

A. Description of original monument and accessories and/or subsequent restoration:

B-1	1817	G.L.O.	Notes	Wampler	NA	Post
	1987	L.C.R.C.	L. 4375 P. 725			Conc. Mon. (B1 T2N R12E)
	1988	L.C.R.C.	L. 4507 P. 851	Spencer	#13044	Metal Disk in 4" Conc. Mon.
	1989	L.C.R.C.	L. 4665 P. 607	Patterson	#17631	Conc. Mon. in Berm M-59
	1990	L.C.R.C.	L. 4854 P. 208	Patterson	#17631	Iron (B1 T2N R12E)

B. Description of corner evidence found and/or method applied in restoring or reestablishing corner:

<p>B-1 Found 4" concrete monument in median of M-59. Monument has brass disc (no markings). Checks following.</p> <p>L.C.R.C. L. 4375 P. 725 Edge of W.B. M-59 Pave. N 9.00' Edge E.B. M-59 Pave. S 61.00'</p> <p>L.C.R.C. L. 4854 P. 208 Sta. 548+00 N 50° W 106.41' Sta. 549+00 N 10° W 32.02' Sta. 550+00 N 70° E 100.95'</p>	<p>L.C.R.C. L. 4507 P. 1385 + Sta. 550+00 W.B. M-59 N 83° E 100.95' + Sta. 549+00 W.B. M-59 N 10° E 32.02' + Sta. 549+00 E.B. M-59 S 15° W 83.93' + Sta. 550+00 E.B. M-59 S 35° E 127.75'</p> <p>L.C.R.C. L. 4665 P. 607 Edge E.B. Conc. M-59 S 61.00' Edge W.B. Conc. M-59 N 9.00'</p>
--	---


ACCEPTED BY THE MACOMB COUNTY SURVEY PEER GROUP AS THE OFFICIAL CORNER UNDER MICHIGAN PUBLIC ACT 346 OF 1980 AT A MEETING HELD ON 9-20-94

WILLIAM E. SODERBERG, P.S., CHAIRMAN

Measure W 2644.56 to A-1  
Measure E 2651.98 to C-1 (L.C.R.C. L. 4665 P. 607 - 2652.02) (G.L.O. 2640) Common to B-13 T3N, R12E

C. Description of monument for corner and accessories established to perpetuate locating the position of the corner:

- B-1 Replace 4" concrete monument with brass disk in center line median M-59 with 4" concrete monument with aluminum cap stamped "Macomb County Monument MI Act 345 #25854."
- + Station 548+00 W.B. Pavement M-59 N 58° W 106.41
  - + Station 549+00 W.B. Pavement M-59 N 10° E 32.02'
  - + Station 550+00 W.B. Pavement M-59 N 85° E 100.91'
  - + Station 550+00 E.B. Pavement M-59 S 35° E 127.75'
  - + Station 549+00 E.B. Pavement M-59 S 16° W 83.93'
  - + N End 12" RCP N 83° W 104.05'

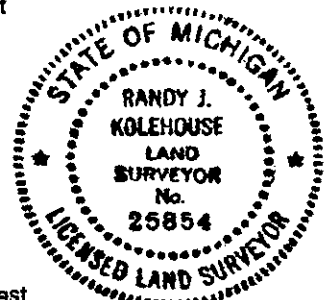

The selected location is accepted by me and is generally accepted by professional surveyors as the best available evidence of the position of the original corner.

Signed by Randy J. Kolehouse Date 10/14/94  
Surveyor's Michigan License No. 25854