

LAND CORNER RECORDATION CERTIFICATE
 Filing Requirement of Act 74, Mich. P.A. 1970

SURVEY &
 REMONUMENTATION


APR 07 1998

SECTION

Register of Deeds Stamp & File Number

For corners in

<u>MACOMB</u> (County)	Located in: City of Sterling Heights	Corner Code # B-9
1. Public Land Survey	T <u>2N</u> R <u>12E</u>	<u>B-9</u>
	T _____ R _____	_____
	T _____ R _____	_____
	T _____ R _____	_____
2. Property Controlling in Section	S _____ T _____ R _____	_____
	S _____ T _____ R _____	_____
3. Miscellaneous Property in Sec.	S _____ T _____ R _____	_____
	S _____ T _____ R _____	_____
4. Lot No. _____, Recorded Plat _____		
5. Private Claims _____		

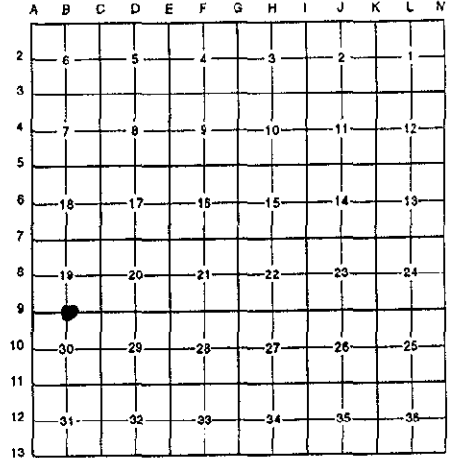

I, Randy Kolehouse, in a field survey on August 14 19 97, do hereby certify that under requirements of P.A. 74 Michigan P.A. of 1970, the corner points mentioned in lines 1 and 2 above were in conformance with regulations and rules therefore as required in the current manual of survey instructions of the United States Department of the Interior, Bureau of Land Management or by a decree of a Court of Law and/or that the corner points mentioned in lines 3, 4 and 5 above were in conformance with the rules of the Michigan Board of Land Surveyors or by a Decree of a Court of Law; established, re-established, monumented, re-monumented, recovered, found as expressed below:

NOTE: Not more than 4 corners, all in the same town and range, may be recorded on this certificate.

A. Description of original monument and accessories and/or subsequent restoration:

B-9	1817	G.L.O. Notes	Wampler	N/A	Post
	1967	MCRC Wit. File No. 116	A.J.R.	N/A	1" Square Iron
	1979	Cert. Survey L. 3122 P. 536	Patterson	#17631	N/A
	1985	M.C. Road Plans #1625	N/A	N/A	N/A
	1987	L.C.R.C. L. 4131 P. 655	Griggs	#01260	Set Rerod
	N/A	Winthrop Sub. No. 1 L. 60 P. 12-14	N/A	N/A	N/A
	N/A	M.C. Tax Maps	N/A	N/A	N/A

B. Description of corner evidence found and/or method applied in restoring or reestablishing corner:

B-9 I found a 1/2" rebar in the C/L median of 16 Mile Road (conc.) running East and West 8' ± East of the East right-of-way line of Garry Street running North per L.C.R.C. L. 4131 P. 655. This point also checks Winthrop Sub. No. 1 L. 60 P. 12-14.

L.C.R.C. L. 4131 P. 655 (1987)
 S 50° W 144.16' P.K. Nail in Utility Pole
 S 26° E 104.29' P.K. Nail in Utility Pole

ACCEPTED BY THE MACOMB COUNTY SURVEY PEER GROUP AS THE OFFICIAL CORNER UNDER MICHIGAN PUBLIC ACT 345 OF 1990 AT A MEETING HELD ON 11/4/97


William E. Soderberg
 WILLIAM E. SODERBERG, P.S., CHAIRMAN

Measure East 2564.65' to C-9 (G.L.O. = 2640.0') (MCRC Plans = 2564.82')
 Measure West 2511.34' to A-9 (G.L.O. = 2649.9') (MCRC Plans = 2511.90')

C. Description of monument for corner and accessories established to perpetuate locating the position of the corner:

B-9 I replaced the found 1/2" rebar with a 4" x 36" conc. Monument with a 1/2" x 36" iron rod w/2" diameter aluminum cap stamped "Macomb County Monument MI Act 345 #25854."

N 05° W 119.52' - Found C/L Top Nut Hyd.
 S 86° E 48.36' - Set P.K. Nail & Macomb Co. Remon. Tag in S Side 6" Tree
 S 21° E 104.19' - Set P.K. Nail & Macomb Co. Remon. Tag in NE Face P. Pole
 S 55° W 144.21' - Set P.K. Nail & Macomb Co. Remon. Tag in NW Face P. Pole

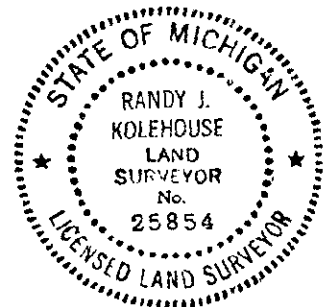

The selected location is accepted by me and is generally accepted by professional surveyors as the best available evidence of the position of the original corner.

Signed by Randy J. Kolehouse Date 11/14/97
 Surveyor's Michigan License No. 25854

741