

# SURVEY & REMONUMENTATION

APR 28 1995

C152239

## COMMISSION

### LAND CORNER RECORDATION CERTIFICATE Filing Requirement of Act 74, Mich. P.A. 1970

94 DEC 14 AM 10: 53

For corners in

MACOMB

(County)

Located In: Sterling Township Corner Code # C-2


MACOMB COUNTY, MI

- |                                    |             |              |         |  |            |
|------------------------------------|-------------|--------------|---------|--|------------|
| 1. Public Land Survey              | T <u>2N</u> | R <u>12E</u> |         |  | <u>C-2</u> |
|                                    | T _____     | R _____      |         |  | _____      |
|                                    | T _____     | R _____      |         |  | _____      |
|                                    | T _____     | R _____      |         |  | _____      |
| 2. Property Controlling in Section | S _____     | T _____      | R _____ |  | _____      |
|                                    | S _____     | T _____      | R _____ |  | _____      |
| 3. Miscellaneous Property in Sec.  | S _____     | T _____      | R _____ |  | _____      |
|                                    | S _____     | T _____      | R _____ |  | _____      |

LIBER **6527** PAGE **816**

Register of Deeds Stamp & File Number

4. Lot No. \_\_\_\_\_, Recorded Plat \_\_\_\_\_
5. Private Claims \_\_\_\_\_

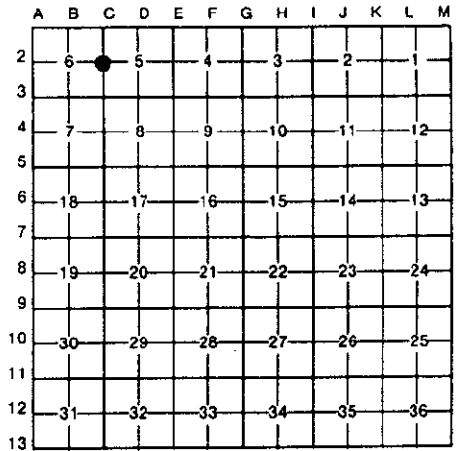

I, Randy Kolehouse, in a field survey on June 23, 19 94, do hereby certify that under requirements of P.A. 74, Michigan P.A. of 1970, the corner points mentioned in lines 1 and 2 above were in conformance with regulations and rules therefore as required in the current manual of survey instructions of the United States Department of the Interior, Bureau of Land Management or by a decree of a Court of Law and/or that the corner points mentioned in lines 3, 4 and 5 above were in conformance with the rules of the Michigan Board of Land Surveyors or by a Decree of a Court of Law; established, re-established, monumented, re-monumented, recovered, found as expressed below:

**NOTE: Not more than 4 corners, all in the same town and range, may be recorded on this certificate.**

**A. Description of original monument and accessories and/or subsequent restoration:**

| C-2 | 1817 | G.L.O.   | Notes           | Wampler   | NA     | Post                 |
|-----|------|----------|-----------------|-----------|--------|----------------------|
|     | 1972 | L.C.R.C. | L. 2273 P. 713  | NA        | NA     | 1" Iron Rod          |
|     | 1972 | L.C.R.C. | L. 2351 P. 326  | Avey      | #15396 | 1" Square Bar        |
|     | 1974 | L.C.R.C. | L. 2472 P. 795  | Patterson | #17631 | Steel Spike          |
|     | 1985 | L.C.R.C. | L. 3884 P. 69   | Fenn      | #23505 | 1" Square Steel Rod  |
|     | 1987 | L.C.R.C. | L. 4375 P. 723  | Kobs      | #14097 | 1/2" Square Iron Bar |
|     | 1988 | L.C.R.C. | L. 4507 P. 844  | Spencer   | #13044 | Steel Spike          |
|     | 1988 | L.C.R.C. | L. 4584 P. 241  | Avey      | #30076 | 1" Square Bar        |
|     | 1990 | L.C.R.C. | L. 04854 P. 206 | Patterson | #17631 | Fnd. Iron            |
|     | 1992 | L.C.R.C. | L. 5300 P. 263  | Kobs      | #14097 | 1" Square Iron Bar   |

**B. Description of corner evidence found and/or method applied in restoring or reestablishing corner:**

C-2 Found 3/4" square iron rod 2' ± West of traveled center line of road on line of remains of fence running East.

L.C.R.C. L. 3884 P. 69 #1185  
PK in SW Face 10" Apple NNW 87.07'  
PK in W Face Util. Pole SSW 123.25'

L.C.R.C. L. 4854 P. 206 #1527  
PK in Util. Pole S 25° W 123.22'

Measure N. 3340.93 feet to C1 (L.C.R.C. L. 2273 P. 714 = 3341.00') (G.L.O. 3366.7)  
Measure S. 2686.87 feet to C2 (Vineyards Sub. No. 1 = 2686.87) (G.L.O. 2640)

ACCEPTED BY THE MACOMB COUNTY SURVEY P  
GROUP AS THE OFFICIAL CORNER UNDER MICH  
PUBLIC ACT 345 OF 1990 AT A MEETING H  
ON 8-16-94  
William E. Soderberg  
WILLIAM E. SODERBERG, P.S., CHAIRMAN

**C. Description of monument for corner and accessories established to perpetuate locating the position of the corner:**

C-2 I replaced the found 3/4" Square Iron Rod with a 3/4" x 24" Iron Rod w/2" diameter aluminum cap stamped "Macomb County Monument MI Act 345 #25854," set Monument Box.

Nail & Tag in SW Face 12" Apple N 15° W 87.07'  
PK in W Face Util. Pole S 24° W 123.22'  
Top Center Line Hyd. S 67° W 58.61'  
Nail & MDOT Tag NE Face Util. Pole S 10° E 124.42'  
3/4" Iron S 82° E 59.88'

The selected location is accepted by me and is generally accepted by professional surveyors as the best available evidence of the position of the original corner.

Signed by Randy J. Kolehouse

Date 10/14/94

Surveyor's Michigan License No. 25854

