

**SURVEY &
REMONUMENTATION**

C152240

APR 28 1995

**LAND CORNER RECORDATION CERTIFICATE
Filing Requirement of Act 74, Mich. P.A. 1970**

94 DEC 14 AM 10:53

For corners in **COMMISSION**


CAMERON LUGH
REGISTER OF DEEDS
MACOMB COUNTY, MI

MACOMB (County)	Located In: Sterling Township	Corner Code #
1. Public Land Survey	T <u>2N</u> R <u>12E</u>	<u>C-3</u>
	T _____ R _____	_____
	T _____ R _____	_____
	T _____ R _____	_____
2. Property Controlling in Section	S _____ T _____ R _____	_____
	S _____ T _____ R _____	_____
3. Miscellaneous Property in Sec.	S _____ T _____ R _____	_____
	S _____ T _____ R _____	_____

LIBER **6527** PAGE **817**

Register of Deeds Stamp & File Number

4. Lot No. _____, Recorded Plat _____
5. Private Claims _____

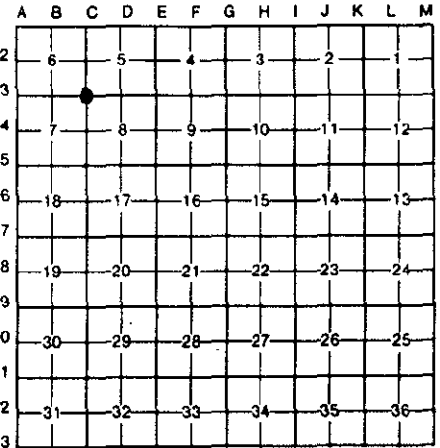

I, Randy Kolehouse, in a field survey on June 23, 19 94, do hereby certify that under requirements of P.A. 74, Michigan P.A. of 1970, the corner points mentioned in lines 1 and 2 above were in conformance with regulations and rules therefore as required in the current manual of survey instructions of the United States Department of the Interior, Bureau of Land Management or by a decree of a Court of Law and/or that the corner points mentioned in lines 3, 4 and 5 above were in conformance with the rules of the Michigan Board of Land Surveyors or by a Decree of a Court of Law; established, re-established, monumented, re-monumented, recovered, found as expressed below:

NOTE: Not more than 4 corners, all in the same town and range, may be recorded on this certificate.

A. Description of original monument and accessories and/or subsequent restoration:

C-3	1817	G.L.O.	Notes	Wampler	NA	Post
	1973	L.C.R.C.	L. 2380 P. 494	Patterson	#17631	Iron in Center Line of Bit. Road
	1977	Survey	L. 2765 P. 339	Pawlaczyk	#17632	Fnd. Mon. Box
	1977	L.C.R.C.	L. 2765 P. 340	Pawlaczyk	#17632	Fnd. Iron in Mon. Box
	1977	L.C.R.C.	L. 2765 P. 341	Pawlaczyk	#17632	Fnd. Iron in Mon. Box
	1977	L.C.R.C.	L. 2886 P. 440	Patterson	#17631	1/2" Iron Mon. Box
	1985	L.C.R.C.	L. 3884 P. 69	Fenn	#23505	Fnd. Pipe in Mon. Box
	1990	L.C.R.C.	L. 04854 P. 206	Patterson	#17631	Fnd. Iron in Mon. Box
	1992	L.C.R.C.	L. 5300 P. 263	Kobs	#14097	Fnd. 1" Pipe in Mon. Box.

B. Description of corner evidence found and/or method applied in restoring or reestablishing corner:


C-3	Found 1" Iron in monument box at center line intersection of Ryan and 19 Mile Roads.
	L.C.R.C. L. 2380 P. 287 Boat Spk. in Util. Pole NW'ly 45.50' L.C.R.C. L. 2765 P. 339 G.W. Tag #6801 in Util. Pole NW 46.2'
	L.C.R.C. L. 4854 P. 206 PK in Util. Pole N 70° W 46.31' Center Line Hyd. N 62° E 105.85' Nail in Util. Pole S 60° E 50.61' Center Line Hyd. S 34° W 77.48'

Measure N. 2686.87 feet North to C-2 (Vineyard Sub. No. 1 = 2686.87') (G.L.O. 2640)
Measure E. 2675.05 to D-3 (G.L.O. 2658.5)

C. Description of monument for corner and accessories established to perpetuate locating the position of the corner:

C-3	I replaced the found 1" Iron with a 3/4" x 24" Iron Rod w/2" diameter aluminum cap stamped "Macomb County Monument MI Act 345 #25854" in an existing Monument Box.
	Nail & Tag G.W. #6801 SW Face P. Pole N 42° W 46.16' Dbl. Head Nail NE Face P. Pole S 44° E 50.57' Top Center Line Hyd. N 69° E 105.56' Top Center Line Hyd. S 45° W 77.27'

ACCEPTED BY THE MACOMB COUNTY SURVEY PEER GROUP AS THE OFFICIAL CORNER UNDER MICHIGAN PUBLIC ACT 345 OF 1990 AT A MEETING HELD ON 9-20-94
William E. Soderberg
WILLIAM E. SODERBERG, P.S., CHAIRMAN

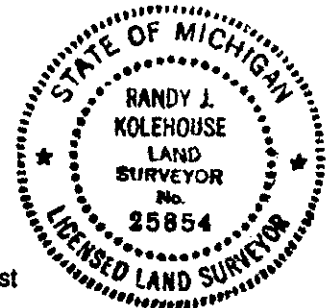

The selected location is accepted by me and is generally accepted by professional surveyors as the best available evidence of the position of the original corner.

Signed by *Randy J. Kolehouse* Date 10/14/94
Surveyor's Michigan License No. 25854