

LAND CORNER RECORDATION CERTIFICATE
Filing Requirement of Act 74, Mich. P.A. 1970

For corners in

<u>MACOMB</u> (County)		Located in: City of Sterling Heights	Corner Code # C-8
1. Public Land Survey	T <u>2N</u> R <u>12E</u>	_____	
	T _____ R _____	_____	
	T _____ R _____	_____	
	T _____ R _____	_____	
2. Property Controlling in Section	S _____ T _____ R _____	_____	
	S _____ T _____ R _____	_____	
3. Miscellaneous Property in Sec.	S _____ T _____ R _____	_____	
	S _____ T _____ R _____	_____	
4. Lot No. _____, Recorded Plat _____			
5. Private Claims _____			

**SURVEY &
 REMONUMENTATION**

APR 07 1998

SECTION

Register of Deeds Stamp & File Number

I, Randy Kolehouse, in a field survey on July 23 19 97, do hereby certify that under requirements of P.A. 74 Michigan P.A. of 1970, the corner points mentioned in lines 1 and 2 above were in conformance with regulations and rules therefore as required in the current manual of survey instructions of the United States Department of the Interior, Bureau of Land Management or by a decree of a Court of Law and/or that the corner points mentioned in lines 3, 4 and 5 above were in conformance with the rules of the Michigan Board of Land Surveyors or by a Decree of a Court of Law; established, re-established, monumented, re-monumented, recovered, found as expressed below:

NOTE: Not more than 4 corners, all in the same town and range, may be recorded on this certificate.

A. Description of original monument and accessories and/or subsequent restoration:

C-8	1817	G.L.O. Notes	Wampler	N/A	Post
	1952	Glenmere Acres Sub. L. 27 P. 22	J. Lehner	#5787	N/A
	1955	Pokley Sub.	Bridges	#5779	N/A
	1967	MCRC Wit. File #94	A.J.R.	N/A	1/2" Iron
	1972	L.C.R.C. L. 2346 P. 633	Patterson	#17631	1/2" Iron
	N/A	Carpathia Gardens Sub. L. 63 P. 3	N/A	N/A	N/A
	1972	Carpathia North Sub. L. 64 P. 11-12	Menzel	#7313	N/A
	1978	Surrey Estates Sub. L. 72 P. 11	Menzel	#7313	N/A
	1979	Cert. Survey. L. 3089 P. 924-926	Soderberg	#17635	3/4" Pipe
	1979	Cert. Survey. L. 3089 P. 927-928	Soderberg	#17635	3/4" Pipe
	1979	Cert. Survey. L. 3089 P. 929-930	Soderberg	#17635	3/4" Pipe
	1979	L.C.R.C. L. 3089 P. 943	Soderberg	#17635	3/4" Pipe
	1986	Chestnut Hills Sub. No. 1 L. 80 P. 15	N/A	N/A	N/A
	N/A	M.C. Tax Maps	N/A	N/A	N/A

B. Description of corner evidence found and/or method applied in restoring or reestablishing corner:

C-8 I found a 1/2" rebar in a monument box at the C/L intersection of Ryan Road (conc.) running North and South and Foxhill Road (conc.) running East and West which checks with witnesses listed below.

L.C.R.C. L. 2346 P. 633 (1972)	L.C.R.C. L. 3089 P. 943 (1979)
Northwesterly 68.96 ft. Top Nut on Hydrant (m. 68.97')	S.E. 66.35' Nail & Shiner DE Pole (m. 66.21')
Southeasterly 66.00 ft. P.K. Nail in Utility Pole (m. 66.21')	S.W. 49.15' Nail & Shiner DE Pole (m. 55.33')
Southwesterly 48.25 ft. P.K. Nail in Utility Pole (55.33')	N.W. 69.00' Top Hydrant (m. 68.97')

Measure North 2672.74' to C-7 (G.L.O. = 2640.0') (Chestnut Hills Sub. No. 1 = 2672.83')
 Measure South 2665.66' to C-9 (G.L.O. = 2640.0') (Glenmere Acres Sub. = 2665.95')

C. Description of monument for corner and accessories established to perpetuate locating the position of the corner:


C-8 I replaced the found 1/2" rebar with a 3/4" x 24" iron rod w/2" diameter aluminum cap stamped "Macomb County Monument MI Act 345 #25854" in an existing monument box.

- N 55° W 68.97' - Found Top C/L Bolt on Hydrant
- S 50° W 55.33' - Set P.K. Nail & Macomb Co. Remon. Tag in SE Side P. Pole
- S 45° E 66.21' - Set P.K. Nail & Macomb Co. Remon. Tag in SW Side P. Pole
- N 43° W 68.14' - Set P.K. Nail & Macomb Co. Remon. Tag in NE Side P. Pole


The selected location is accepted by me and is generally accepted by professional surveyors as the best available evidence of the position of the original corner.

Signed by Randy J. Kolehouse
 Surveyor's Michigan License No. 25854

Date 11/14/97

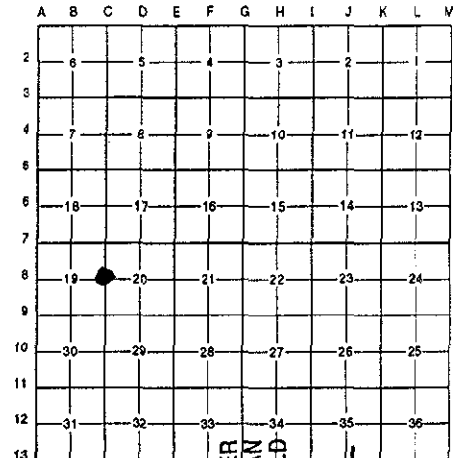

ACCEPTED BY THE MACOMB COUNTY SURVEY PEER GROUP AS THE OFFICIAL CORNER UNDER MICHIGAN PUBLIC ACT 345 OF 1990 AT A MEETING HELD ON 11/14/97
 WILLIAM E. SODERBERG, P.S., CHAIRMAN

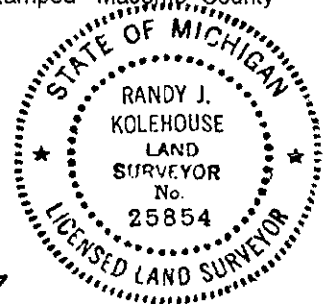

743