

LAND CORNER RECORDATION CERTIFICATE
 Filing Requirement of Act 74, Mich. P.A. 1970

For corners in

<u>MACOMB</u> (County)	Located in: City of Sterling Heights	Corner Code # C-9
1. Public Land Survey	T <u>2N</u> R <u>12E</u>	<u>C-9</u>
	T _____ R _____	_____
	T _____ R _____	_____
	T _____ R _____	_____
2. Property Controlling in Section	S _____ T _____ R _____	_____
	S _____ T _____ R _____	_____
3. Miscellaneous Property in Sec.	S _____ T _____ R _____	_____
	S _____ T _____ R _____	_____
4. Lot No. _____, Recorded Plat _____		
5. Private Claims _____		

SURVEY &
 REMONUMENTATION

APR 07 1998

SECTION

Register of Deeds Stamp & File Number

I, Randy Kolehouse, in a field survey on July 23 19 97, do hereby certify that under requirements of P.A. 74 Michigan P.A. of 1970, the corner points mentioned in lines 1 and 2 above were in conformance with regulations and rules therefore as required in the current manual of survey instructions of the United States Department of the interior, Bureau of Land Management or by a decree of a Court of Law and/or that the corner points mentioned in lines 3, 4 and 5 above were in conformance with the rules of the Michigan Board of Land Surveyors or by a Decree of a Court of Law; established, re-established, monumented, re-monumented, recovered, found as expressed below:

NOTE: Not more than 4 corners, all in the same town and range, may be recorded on this certificate.


A. Description of original monument and accessories and/or subsequent restoration:

C-9	1817	G.L.O. Notes	Wampler	N/A	Post
	1945	Sterling Gardens Sub. L. 23 P. 4	W. Lehner	#1123	N/A
	1952	Glenmere Acres Sub. L. 27 P. 22	J. Lehner	#5787	N/A
	1967	MCRC Wit. File No. 115	A.J.R.	N/A	1/2" Iron
	1989	M.C. Road Plans #1625	N/A	N/A	N/A
	1989	L.C.R.C. L. 04723 P. 181	Landwehr	#10065	5/8" Iron
	N/A	M.C. Tax Maps	N/A	N/A	N/A

B. Description of corner evidence found and/or method applied in restoring or reestablishing corner:

C-9 I found a 5/8" iron bar in a monument box on the C/L of Ryan Road (conc.) running North and South on construction C/L of 16 Mile Road (conc.) running East and West which checks with witnesses listed below.

L.C.R.C. L. 04723 P. 181 (1989)
 N 50° W 43.20' cen post NO LEFT TURN sign (m. 42.15')
 N 50° E cen post NO LEFT TURN sign (m. 50.31')
 East 30.5' back of curb
 West 29.9' back of curb

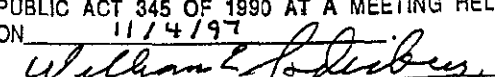ACCEPTED BY THE MACOMB COUNTY SURVEY PEER GROUP AS THE OFFICIAL CORNER UNDER MICHIGAN PUBLIC ACT 345 OF 1990 AT A MEETING HELD ON 11/14/97

 WILLIAM E. SODERBERG, P.S., CHAIRMAN

Measure North 2665.66' to C-8 (G.L.O. = 2640.0') (Glenmere Acres Sub. = 2665.95')
 Measure South 2677.12' to C-10 (G.L.O. = 2640.0') (Macomb Co. Tax Maps = 2676.98')
 Measure East 2817.44' to D-9 (G.L.O. = 2646.9') (MCRC Plans = 2817.63')
 Measure West 2564.65' to B-9 (G.L.O. = 2640.0') (MCRC Plans = 2564.82')


C. Description of monument for corner and accessories established to perpetuate locating the position of the corner:

C-9 I replaced the found 5/8" iron bar with a 3/4" x 24" iron rod w/2" diameter aluminum cap stamped "Macomb County Monument MI Act 345 #25854" in an existing monument box.

N 50° W 42.15' - Found Center Post of No Left Turn Sign
 N 50° E 50.31' - Found Center Post of No Left Turn Sign
 East 30.47' - Found Back of Curb
 West 29.88' - Found Back of Curb
 S 89° E 50.43' - Set P.K. Nail & Macomb Co. Remon. Tag in S Face P. Pole
 N 32° W 33.57' - Set "X" Cut on SE Side Rim to M.H.

The selected location is accepted by me and is generally accepted by professional surveyors as the best available evidence of the position of the original corner.

Signed by Randy J. Kolehouse Date 11/14/97
 Surveyor's Michigan License No. 25854

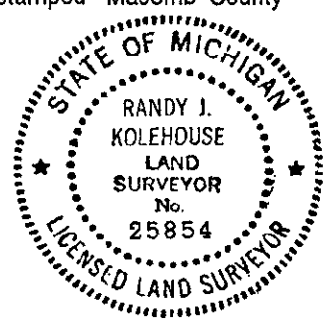

744