

SURVEY & REMONUMENTATION

APR 28 1995

LAND CORNER RECORDATION CERTIFICATE

C152200

COMMISSION

Filing Requirement of Act 74, Mich. P.A. 1970

r corners in	<u>MACOMB</u>	Located in:	<u>Sterling Township</u>	Corner Code \neq	
	(County)				
Public Land Survey	T <u>2N</u> R <u>12E</u>			<u>D-1</u>	
	T _____ R _____			_____	
	T _____ R _____			_____	
	T _____ R _____			_____	
Property Controlling in Section	S _____ T _____ R _____			_____	
Miscellaneous	S _____ T _____ R _____			_____	
Property in Sec.	S _____ T _____ R _____			_____	


LIBER **6527** PAGE **777**

94 DEC 14 AM 10:50

CARY
REG
MSDP
LAUGH
DEEDS
FILE NUMBER

Register of Deeds Stamp & File Number

Lot No. _____, Recorded Plat _____
Private Claims _____

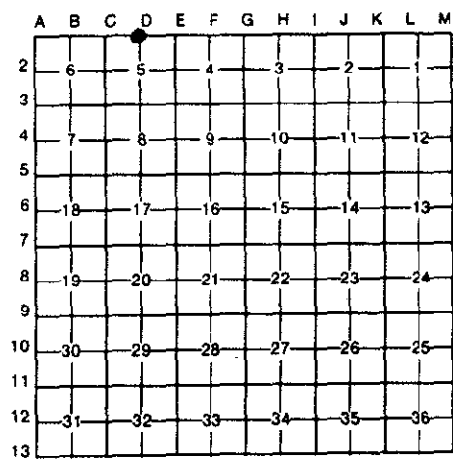

Randy Kolehouse, in a field survey on July 28, 19 94, hereby certify that under requirements of P.A. 74, Michigan P.A. of 1970, the corner points mentioned in lines 1 and 2 above were in conformance with regulations and rules therefore as required in the recent manual of survey instructions of the United States Department of the Interior, Bureau of Land Management or by a decree of a Court of Law and/or that the corner points mentioned in lines 3, 4 and 5 above were in conformance with the rules of the Michigan Board of Land Surveyors or by a Decree of a Court of Law; established, re-established, monumented, re-monumented, recovered, found as pressed below:

NOTE: Not more than 4 corners, all in the same town and range, may be recorded on this certificate.

Description of original monument and accessories and/or subsequent restoration:

-1	1817 1989	G.L.O. L.C.R.C.	Notes L. 4606 P. 101	Wampler Patterson	NA #17631	Post 1/2" Iron
----	--------------	--------------------	-------------------------	----------------------	--------------	-------------------

Description of corner evidence found and/or method applied in restoring or reestablishing corner:

- 1 Found 1/2" rebar in right-of-way fence south side of M-59 at approximately Station 41+15.

E Face 14" Ash N 05° W 11.50'
W. Face P. Pole N 25° E 71.86'
S Face P. Pole N 80° E 80.50'
N Face 8" Elm West 15.41'

Measure 2659.76 West to C-13 (G.L.O. 2640)
Measure 2635.36 East to E-13 (G.L.O. 2640)

ACCEPTED BY THE MACOMB COUNTY SURVEY PEER GROUP AS THE OFFICIAL CORNER UNDER MICHIGAN PUBLIC ACT 345 OF 1990 AT A MEETING HELD ON 9-20-94

William E. Soderberg
WILLIAM E. SODERBERG, P.S., CHAIRMAN

Common With D-13 T3N, R12E

Description of monument for corner and accessories established to perpetuate locating the position of the corner:

- 1 I replaced the found 1/2" rebar with a 3/4" x 24" Iron Rod w/2" diameter aluminum cap stamped "Macomb County Monument MI Act 345 #25854."

PK with Macomb Co. Remon. Tag E Face 20" Cottonwood N 3° W 11.53'
PK with Macomb Co. Remon. Tag S Face 10" Elm 4 ± Off Ground N 85° W 15.41'
PK with Macomb Co. Remon. Tag S Face Util. Pole N 83° E 80.55'
PK with Macomb Co. Remon. Tag W Face Util. Pole N 18° E 71.87'

The selected location is accepted by me and is generally accepted by professional surveyors as the best available evidence of the position of the original corner.

Recorded by Randy J. Kolehouse Date 10/14/94
Surveyor's Michigan License No. 25854

