

LAND CORNER RECORDATION CERTIFICATE
 Filing Requirement of Act 74, Mich. P.A. 1970

For corners in

<u>MACOMB</u> (County)	Located in: City of Sterling Heights	Corner Code #
1. Public Land Survey	T <u>2N</u> R <u>12E</u>	<u>D-9</u>
	T _____ R _____	_____
	T _____ R _____	_____
	T _____ R _____	_____
2. Property Controlling in Section	S _____ T _____ R _____	_____
	S _____ T _____ R _____	_____
3. Miscellaneous Property in Sec.	S _____ T _____ R _____	_____
	S _____ T _____ R _____	_____
4. Lot No. _____, Recorded Plat _____		
5. Private Claims _____		

SURVEY &
 REMONUMENTATION


APR 07 1998

ACCEPTED BY THE MACOMB COUNTY SURVEY PEER
 GROUP AS THE OFFICIAL CORNER UNDER MICHIGAN
 PUBLIC ACT 345 OF 1990 AT A MEETING HELD
 ON 11/14/97

William E. Soderberg
 WILLIAM E. SODERBERG, P.S., CHAIRMAN
 Register of Deeds Stamp & File Number

I, Randy Kolehouse, in a field survey on July 23 19 97, do hereby certify that under requirements of P.A. 74 Michigan P.A. of 1970, the corner points mentioned in lines 1 and 2 above were in conformance with regulations and rules therefore as required in the current manual of survey instructions of the United States Department of the Interior, Bureau of Land Management or by a decree of a Court of Law and/or that the corner points mentioned in lines 3, 4 and 5 above were in conformance with the rules of the Michigan Board of Land Surveyors or by a Decree of a Court of Law; established, re-established, monumented, re-monumented, recovered, found as expressed below:

NOTE: Not more than 4 corners, all in the same town and range, may be recorded on this certificate.

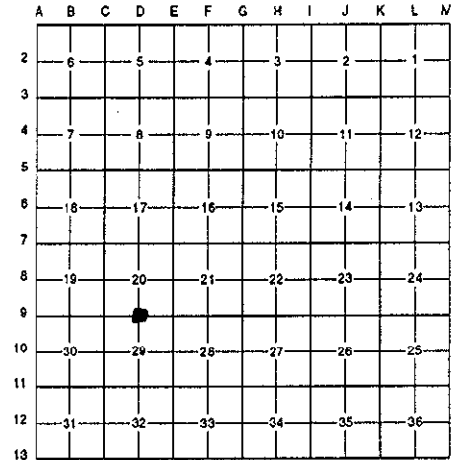

A. Description of original monument and accessories and/or subsequent restoration:

D-9	1817	G.L.O. Notes	Wampler	N/A	Post
	1967	MCRC Wit. File No. 114	A.J.R.	N/A	1/2" Iron
	1972	Essex North Sub. L. 63 P. 7-8	Menzel	#7313	N/A
	1985	M.C. Road Plans #1625	N/A	N/A	N/A
	1986	L.C.R.C. L. 4072 P. 919	Money	#30092	3/8" Steel Bar
	1989	L.C.R.C. L. 04723 P. 181	Landwehr	#10065	1/2" Re-rod
	N/A	Essex Gardens Sub. L. 59 P. 50-51	N/A	N/A	N/A
	N/A	Parkway Estates Sub. L. 75 P. 4-5	Menzel	#7313	N/A
	N/A	M.C. Tax Maps	N/A	N/A	N/A

B. Description of corner evidence found and/or method applied in restoring or reestablishing corner:

D-9 I found a 1/2" rebar in the median 53' ± North of the C/L of eastbound 16 Mile Road (bit.) running East and West which checks with witnesses listed below.

L.C.R.C. L. 4072 P. 919 (1986)	L.C.R.C. L. 04723 P. 181 (1989)
N.N.E. 43.05 CENTER GVW	33.2' North back of curb (m. 33.48')
	33.5' East cen lamp post (m. 33.41')
	33.4' South back of curb (m. 33.12')
	46.35' S. 60° W. cen post ONE-WAY sign (m. 46.58')


Measure East 2770.11' to E-9 (G.L.O. = 2646.9') (MCRC Plans = 2768.55')
 Measure West 2817.44' to C-9 (G.L.O. = 2646.9') (MCRC Plans = 2817.63')

C. Description of monument for corner and accessories established to perpetuate locating the position of the corner:

D-9 I replaced the found 1/2" rebar with a 4" x 36" concrete monument w/2" diameter aluminum cap stamped "Macomb County Monument MI Act 345 #25854."

- Due North 33.48' - Found Back of Curb
- Due South 33.12' - Found Back of Curb
- Due East 33.41' - Found Center Lamp or Light Post
- S 60° E 46.58' - Found Center Post One-Way Sign
- S 08° W 95.15' - Set P.K. Nail & Macomb Co. Remon. Tag in W Side Util. Pole

The selected location is accepted by me and is generally accepted by professional surveyors as the best available evidence of the position of the original corner.

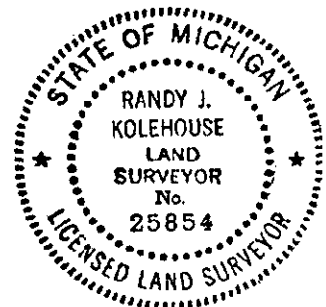

Signed by Randy J. Kolehouse Date 11/14/97
 Surveyor's Michigan License No. 25854

748