

LAND CORNER RECORDATION CERTIFICATE  
 Filing Requirement of Act 74, Mich. P.A. 1970

SURVEY &  
 REMONUMENTATION

APR 07 1998

SECTION


Register of Deeds Stamp & File Number

For corners in

MACOMB  
 (County)

Located in: City of Sterling Heights Corner Code # \_\_\_\_\_

- |                                       |             |              |             |
|---------------------------------------|-------------|--------------|-------------|
| 1. Public Land Survey                 | T <u>2N</u> | R <u>12E</u> | <u>D-11</u> |
|                                       | T _____     | R _____      | _____       |
|                                       | T _____     | R _____      | _____       |
|                                       | T _____     | R _____      | _____       |
| 2. Property Controlling in Section    | S _____     | T _____      | R _____     |
|                                       | S _____     | T _____      | R _____     |
| 3. Miscellaneous Property in Sec.     | S _____     | T _____      | R _____     |
|                                       | S _____     | T _____      | R _____     |
| 4. Lot No. _____, Recorded Plat _____ |             |              |             |
| 5. Private Claims _____               |             |              |             |

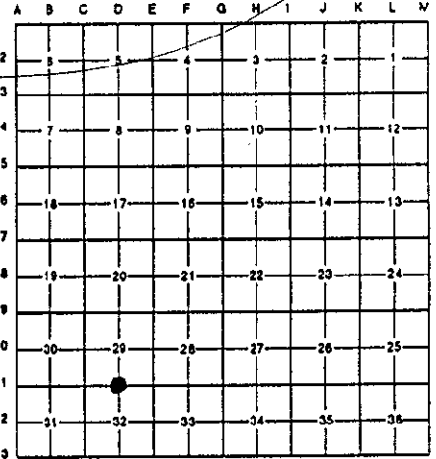

I, Randy Kolehouse, in a field survey on August 14 19 97, do hereby certify that under requirements of P.A. 74 Michigan P.A. of 1970, the corner points mentioned in lines 1 and 2 above were in conformance with regulations and rules therefore as required in the current manual of survey instructions of the United States Department of the Interior, Bureau of Land Management or by a decree of a Court of Law and/or that the corner points mentioned in lines 3, 4 and 5 above were in conformance with the rules of the Michigan Board of Land Surveyors or by a Decree of a Court of Law; established, re-established, monumented, re-monumented, recovered, found as expressed below:

NOTE: Not more than 4 corners, all in the same town and range, may be recorded on this certificate.

A. Description of original monument and accessories and/or subsequent restoration:

D-11	1817	G.L.O. Notes	Wampler	N/A	Post
	1928	MCRC Wit. File No. 140	N/A	N/A	3/4" Gas Pipe
	1936	Supervisors Plat No. 7 L. 18 P. 6	McCarthy	N/A	N/A
	1966	Shell Heights Sub. L. 57 P. 24-25	N/A	N/A	N/A
	1972	L.C.R.C. L. 2315 P. 848-849	Webster	#11302	1" Iron
	1972	Cert. Survey L. 2267 P. 850	Webster	#11302	1" Iron
	1972	Cert. Survey L. 2302 P. 147	Webster	#11302	1" Iron
	1972	Cert. Survey L. 2302 P. 149	Webster	#11302	1" Iron
	1975	Cert. Survey L. 2581 P. 676-677	Webster	#11302	1" Iron
	N/A	M.C. Tax Maps	N/A	N/A	N/A

B. Description of corner evidence found and/or method applied in restoring or reestablishing corner:

D-11 I found a 1/2" rebar on the C/L of 15 Mile Road (conc.) running East and West and the East right-of-way line of Koch Road (conc.) that checks monumentation found in Supervisors Plat No. 7, Shell Heights Sub., and Cert. Survey L. 2267 P. 850.

ACCEPTED BY THE MACOMB COUNTY SURVEY PEER GROUP AS THE OFFICIAL CORNER UNDER MICHIGAN PUBLIC ACT 345 OF 1990 AT A MEETING HELD ON 11/14/97


William E. Soderberg  
 WILLIAM E. SODERBERG, P.S., CHAIRMAN

Measure East 2825.36' to E-11 (G.L.O. = 2659.5')  
 Measure West 2811.51' to C-11 (G.L.O. = 2659.5')

C. Description of monument for corner and accessories established to perpetuate locating the position of the corner:

D-11 I replaced the found 1/2" rebar with a 3/4" x 24" iron rod w/2" diameter aluminum cap stamped "Macomb County Monument MI Act 345 #25854." Also set a new monument box.

- N 39° E 55.36' - Found C/L Top Nut Hyd.
- S 00° E 99.57' - Found NW Cor. Block Fnd.
- S 44° W 69.71' - Set P.K. Nail & Macomb Co. Remon. Tag in E Side Lt. Pole
- N 31° W 49.60' - Set P.K. Nail & Macomb Co. Remon. Tag in SW Side P. Pole

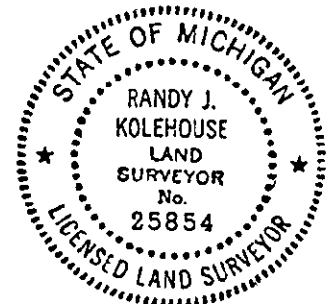

The selected location is accepted by me and is generally accepted by professional surveyors as the best available evidence of the position of the original corner.

Signed by Randy J. Kolehouse Date 11/14/97

Surveyor's Michigan License No. 25854

749