

SURVEY & REMONUMENTATION

C152242

APR 28 1995

LAND CORNER RECORDATION CERTIFICATE

94 DEC 14 AM 10:53

COMMISSION

Filing Requirement of Act 74, Mich. P.A. 1970

For corners in

MACOMB

(County)

Located In: Sterling
Township

Corner Code ≠#


CARYN L. BAUGH
REGISTER OF DEEDS
MACOMB COUNTY, MI

- | | | | | | |
|------------------------------------|-------------|--------------|---------|-------|--|
| 1. Public Land Survey | T <u>2N</u> | R <u>12E</u> | _____ | E-2 | |
| | T _____ | R _____ | _____ | _____ | |
| | T _____ | R _____ | _____ | _____ | |
| | T _____ | R _____ | _____ | _____ | |
| 2. Property Controlling in Section | S _____ | T _____ | R _____ | _____ | |
| | S _____ | T _____ | R _____ | _____ | |
| 3. Miscellaneous Property in Sec. | S _____ | T _____ | R _____ | _____ | |
| | S _____ | T _____ | R _____ | _____ | |

LIBER **6527** PAGE **819**

Register of Deeds Stamp & File Number

4. Lot No. _____, Recorded Plat _____
5. Private Claims _____

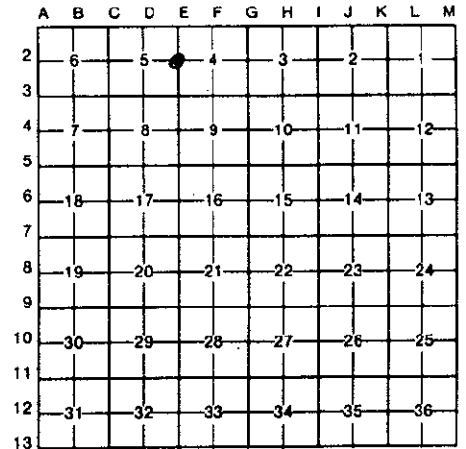

I, Randy Kolehouse, in a field survey on June 23, 19 94

do hereby certify that under requirements of P.A. 74, Michigan P.A. of 1970, the corner points mentioned in lines 1 and 2 above were in conformance with regulations and rules therefore as required in the current manual of survey instructions of the United States Department of the Interior, Bureau of Land Management or by a decree of a Court of Law and/or that the corner points mentioned in lines 3, 4 and 5 above were in conformance with the rules of the Michigan Board of Land Surveyors or by a Decree of a Court of Law; established, re-established, monumented, re-monumented, recovered, found as expressed below:

NOTE: Not more than 4 corners, all in the same town and range, may be recorded on this certificate.

A. Description of original monument and accessories and/or subsequent restoration:

E-2	1817	G.L.O.	Notes	Wampler	NA	Post
	1970	MDOT	NA	Klauza, J.	NA	1/2" Iron Rod
	1978	L.C.R.C.	L 2940 P. 352	Patterson	#17631	1/2" Re-rod
	1988	L.C.R.C.	L 4507 P. 845	Spencer	#13044	1/2" Copper Clad Rod
	1992	MCRC	NA	Campbell, R.	NA	5/8" Iron in Mon. Box


B. Description of corner evidence found and/or method applied in restoring or reestablishing corner:

- E-2 Found 5/8" rebar in monument box in center line of Mound Road.
- | | |
|---|--|
| MDOT
Subdivision Monument W 102'
L.C.R.C. L. 2940 P. 352
Top Nut on Hyd. NW'ly 94.43'
L.C.R.C. L. 4507 P. 845
Center Line Hyd. N 55° W 94.47'
Center Line Hyd. N 70° E 85.80' | M.C.R.C.
"+ SW Bolt Hyd. NE'ly 95.45'
"+ on Back Walks E 101.24'
"+ on N Rim M.H. SSW'ly 52.92'
"+ on E Collar Hyd. WNW 93.66' |
|---|--|
- Measure 2613.13 S. to E-3 (Supervisor's Plat of Eyster's Mound Road Farm #2 = 2614.8) (G.L.O. 2640)
 Measure 3366.28 N. to E-1 (G.L.O. 3377.88)

ACCEPTED BY THE MACOMB COUNTY SURVEY PEER GROUP AS THE OFFICIAL CORNER UNDER MICHIGAN PUBLIC ACT 345 OF 1990 AT A MEETING HELD ON 8-30-94
William E. Soderberg
 WILLIAM E. SODERBERG, P.S., CHAIRMAN

C. Description of monument for corner and accessories established to perpetuate locating the position of the corner:

- E-2 I replaced the found 5/8" Rebar with a 3/4" x 24" Iron Rod w/2" diameter aluminum cap stamped "Macomb County Monument MI Act 345 #25854" in an existing Monument Box.
- "+" SW Bolt on Hyd. N 79° E 95.43'
 "+" Back of Walk E Side Mound Road S 84° E 101.21'
 "+" N Side Rim Storm M.H. S 07° W 52.88'
 Plat Mon. N 85° W 101.95'
 "+" on E Collar of Hyd. N 65° W 93.62'

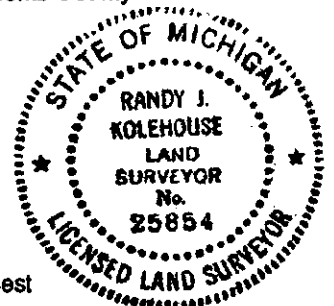

The selected location is accepted by me and is generally accepted by professional surveyors as the best available evidence of the position of the original corner.

Signed by *Randy J. Kolehouse* Date 10/14/94
 Surveyor's Michigan License No. 25854