

# SURVEY & REMONUMENTATION

APR 28 1995

C152245

## COMMISSION LAND CORNER RECORDATION CERTIFICATE

Filing Requirement of Act 74, Mich. P.A. 1970

94 DEC 14 AM 10:53

MICHIGAN  
REGISTER OF DEEDS  
MACOMB COUNTY, MI

LIBER 6527 PAGE 822


Register of Deeds Stamp & File Number

4 corners in  
MACOMB  
(County)

Located In: Sterling Township Corner Code # E-5

Public Land Survey	T <u>2N</u> R <u>12E</u>	<u>E-5</u>
	T _____ R _____	_____
	T _____ R _____	_____
	T _____ R _____	_____
Property Controlling in Section	S _____ T _____ R _____	_____
Miscellaneous	S _____ T _____ R _____	_____
Property in Sec.	S _____ T _____ R _____	_____

Lot No. \_\_\_\_\_ Recorded Plat \_\_\_\_\_  
Private Claims \_\_\_\_\_

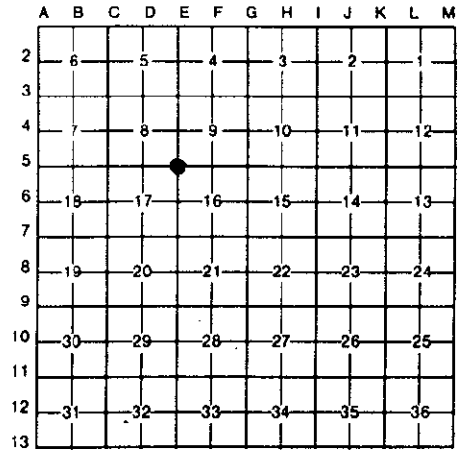

Randy Kolehouse in a field survey on July 25, 1994

hereby certify that under requirements of P.A. 74, Michigan P.A. of 1970, the corner points mentioned in lines 1 and 2 above were in conformance with regulations and rules therefore as required in the current manual of survey instructions of the United States Department of the Interior, Bureau of Land Management or by a decree of a Court of Law and/or that the corner points mentioned in lines 3, 4 and 5 above were in conformance with the rules of the Michigan Board of Land Surveyors or by a Decree of a Court of Law; established, re-established, monumented, re-monumented, recovered, found as pressed below:

**NOTE: Not more than 4 corners, all in the same town and range, may be recorded on this certificate.**

Description of original monument and accessories and/or subsequent restoration:

E-5	1817	G.L.O.	Notes	Wampler	NA	Post
	1976	L.C.R.C.	L. 2703 P. 228	Hooth	#7966	3/4" Hex. Rod in Mon. Box
	1977	L.C.R.C.	L. 2886 P. 438	Patterson	#17631	1" Iron in Mon. Box
	?	MCRC	File #61	NA	NA	1" Pipe

Description of corner evidence found and/or method applied in restoring or reestablishing corner:

E-5 Found 5/8" rebar in monument box at Mound Road & 18 Mile Road.

L.C.R.C. L. 2886 P. 438  
MDSH Nail and Washer in Util. Pole NW'ly 106.55'


Measure N 2635.25 to E-4 MDOT 2635.20 (G.L.O. 2640)  
Measure S 2654.56 to E-6 MDOT 2655.42 (G.L.O. 2640)  
Measure E 2645.73 to E-5 MDOT 2643.45 (G.L.O. 2672.34)  
Measure W 2726.47 to D-5 (G.L.O. 2640)

ACCEPTED BY THE MACOMB COUNTY SURVEY PEER GROUP AS THE OFFICIAL CORNER UNDER MICHIGAN PUBLIC ACT 345 OF 1990 AT A MEETING HELD ON 12-29-94  
*William E. Soderberg*  
WILLIAM E. SODERBERG, P.S., CHAIRMAN

Description of monument for corner and accessories established to perpetuate locating the position of the corner:

E-5 I replaced the found 5/8" Rebar with a 3/4" x 24" Iron Rod w/2" diameter aluminum cap stamped "Macomb County, Michigan Monument MI Act 345 #25854" in an existing Monument Box.

Nail with MDSH Tag SW Face Util. Pole N 56° W 106.39'  
PK SE Face Util. Pole S 66° W 108.13'  
4" Center Line Top Nut Hydrant S 6° E 100.51'  
PK with MCRC Tag SE Face Util. Pole N 68° E 109.46'

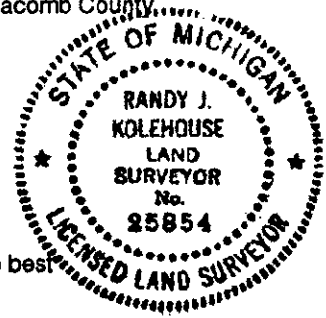

The selected location is accepted by me and is generally accepted by professional surveyors as the best available evidence of the position of the original corner.

Signed by Randy J. Kolehouse Date 10/14/94  
Surveyor's Michigan License No. 25854