

SURVEY & REMONUMENTATION

APR 28 1995

C152247

COMMISSION LAND CORNER RECORDATION CERTIFICATE

Filing Requirement of Act 74, Mich. P.A. 1970

or corners in		Located In:	Sterling Township	Corner Code #:	
<u>MACOMB</u>					
(County)					
Public Land Survey	T <u>2N</u> R <u>12E</u>			<u>E-7</u>	
	T _____ R _____			_____	
	T _____ R _____			_____	
	T _____ R _____			_____	
Property Controlling in Section	S _____ T _____ R _____			_____	
Miscellaneous	S _____ T _____ R _____			_____	
Property in Sec.	S _____ T _____ R _____			_____	

94 DEC 14 AM 10:53

3451
REGISTRY
MICHIGAN

LAUGH
NEEDS
TY, MI


LIBER 6527 PAGE 824

Register of Deeds Stamp & File Number

Lot No. _____, Recorded Plat _____
Private Claims _____

Randy Kolehouse, in a field survey on June 28, 1994,
hereby certify that under requirements of P.A. 74, Michigan P.A. of 1970, the corner points mentioned in lines 1 and 2 above were in conformance with regulations and rules therefore as required in the current manual of survey instructions of the United States Department of the Interior, Bureau of Land Management or by a decree of a Court of Law and/or that the corner points mentioned in lines 3, 4 and 5 above were in conformance with the rules of the Michigan Board of Land Surveyors or by a Decree of a Court of Law; established, re-established, monumented, re-monumented, recovered, found as pressed below:

DTE: Not more than 4 corners, all in the same town and range, may be recorded on this certificate.

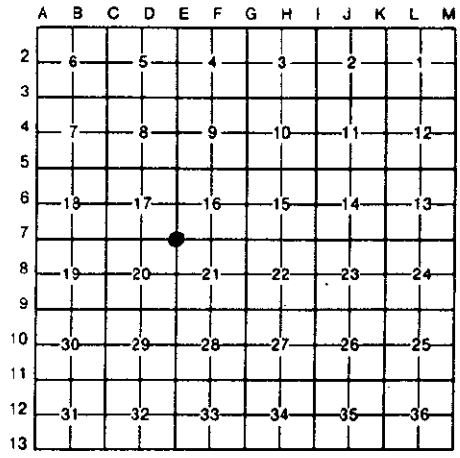

Description of original monument and accessories and/or subsequent restoration:

E-7	1817	G.L.O. MCRC	Notes File #81	Wampler NA	NA NA	Post Metal Washer Center Line Ryan
-----	------	----------------	-------------------	---------------	----------	---------------------------------------

Description of corner evidence found and/or method applied in restoring or reestablishing corner:

E-7 Found Monument Box (no iron) in center line intersection of Mound Road & 17 Mile Road (used center line M.B.). This point checks the NW corner of Victory Gardens Farm as recorded in Liber 22 Page 46 MCR.

Measure N 2621.59 to E-6 (G.L.O. 2640)
Measure S 2673.62 to E-8 (Victory Gardens Farm = 2673.73) (G.L.O. 2640)
Measure E 2641.89 to F-7 (G.L.O. 2646.66)

ACCEPTED BY THE MACOMB COUNTY SURVEY PEER GROUP AS THE OFFICIAL CORNER UNDER MICHIGAN PUBLIC ACT 345 OF 1990 AT A MEETING HELD ON 9-20-94.

William E. Soderberg
WILLIAM E. SODERBERG, P.S., CHAIRMAN

Description of monument for corner and accessories established to perpetuate locating the position of the corner:

E-7 I placed a 3/4" x 24" Iron Rod w/2" diameter aluminum cap stamped "Macomb County Monument MI Act 345 #25854" in an existing Monument Box.

PK in SW Face Util. Pole N 54° W 119.71'
PK & Macomb Co. Remon. Tag in E Face Util. Pole N 06° W 60.63'
PK & Macomb Co. Remon. Tag in SE Face Util. Pole N 65° E 118.88'
PK & Macomb Co. Remon. Tag in NE Face Util. Pole S 54° E 124.78'
PK & Macomb Co. Remon. Tag in SE Face Util. Pole S 61° W 125.74'
C/L Monument Box S 60° W 9.9'



The selected location is accepted by me and is generally accepted by professional surveyors as the best available evidence of the position of the original corner.

Witnessed by Randy J. Kolehouse Date 12/14/94
Surveyor's Michigan License No. 25854