

LAND CORNER RECORDATION CERTIFICATE
Filing Requirement of Act 74, Mich. P.A. 1970

APR 07 1998

For corners in

<u>MACOMB</u> (County)	Located in: City of Sterling Heights	Corner Code #
1. Public Land Survey	T <u>2N</u> R <u>12E</u>	<u>E-9</u>
	T _____ R _____	_____
	T _____ R _____	_____
	T _____ R _____	_____
2. Property Controlling in Section	S _____ T _____ R _____	_____
	S _____ T _____ R _____	_____
3. Miscellaneous Property in Sec.	S _____ T _____ R _____	_____
	S _____ T _____ R _____	_____
4. Lot No. _____, Recorded Plat _____		
5. Private Claims _____		

SECTION


Register of Deeds Stamp & File Number

I, Randy Kolehouse, in a field survey on July 23 19 97, do hereby certify that under requirements of P.A. 74 Michigan P.A. of 1970, the corner points mentioned in lines 1 and 2 above were in conformance with regulations and rules therefore as required in the current manual of survey instructions of the United States Department of the interior, Bureau of Land Management or by a decree of a Court of Law and/or that the corner points mentioned in lines 3, 4 and 5 above were in conformance with the rules of the Michigan Board of Land Surveyors or by a Decree of a Court of Law; established, re-established, monumented, re-monumented, recovered, found as expressed below:

NOTE: Not more than 4 corners, all in the same town and range, may be recorded on this certificate.

A. Description of original monument and accessories and/or subsequent restoration:

E-9	1817	G.L.O. Notes	Wampler	N/A	Post
	N/A	MCRC Wit. File No. 113	N/A	N/A	N/A
	1939	Sup. Plat of Heatherland Sub. L. 19 P. 42	W. Lehner	#123	N/A
	1940	Sup. Plat of Eyster's Mound Road Farms #1 Sub. L. 20 P. 14	W. Lehner	#123	N/A
	1943	Julius Ronkowski Sub.	Gillespie	N/A	N/A
	1973	L.C.R.C. L. 2358 P. 934-935	Cantrell	#5782	5/8" Iron
	1973	Cert. Survey L. 2358 P. 925	Cantrell	#5782	5/8" Rod
	1979	L.C.R.C. L. 3168 P. 262	Fenn	#23505	3/8" Re-rod
	1985	M.C. Road Plans #1625	N/A	N/A	N/A
	1989	L.C.R.C. L. 04723 P. 602	Donnelly	#21563	3/8" Re-rod
	1993	L.C.R.C. L. 06132 P. 804	Feindt	#21566	3/8" Re-rod
	N/A	M.C. Tax Maps	N/A	N/A	N/A

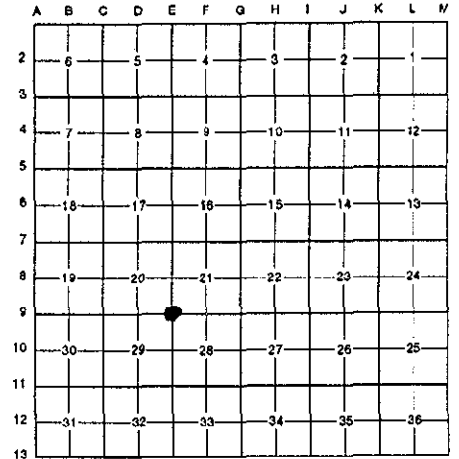

B. Description of corner evidence found and/or method applied in restoring or reestablishing corner:

E-9 I found a capped iron (W.E.S. #17635) in the center island of Mound Road (conc.) running North and South and 16 Mile Road (conc.) running East and West as reset from plats by Lawrence Feindt in 1993 which checks with witnesses listed below.

- L.C.R.C. L. 06132 P. 804 (1993)
- N 40° W - 150.24' - Nail & 21566 cap in NE face of utility pole (m. 150.32')
- N 48° E - 144.75' - Nail & 21566 cap in NW face of utility pole (m. 144.73')
- S 87° E - 116.36' - NW bolt on base of steel light pole (m. 116.40')
- N 85° W - 115.11' - SE bolt on base of steel light pole (m. 115.13')
- Measure North 2677.98' to E-8 (G.L.O. = 2640.0') (MCRC Plans = 2679.0')
- Measure South 2644.50' to E-10 (G.L.O. = 2640.0')
- Measure East 2650.60' to F-9 (G.L.O. = 2632.7')
- Measure West 2770.11' to D-9 (G.L.O. = 2646.9') (MCRC Plans = 2768.55')

ACCEPTED BY THE MACOMB COUNTY SURVEY PEER GROUP AS THE OFFICIAL CORNER UNDER MICHIGAN PUBLIC ACT 345 OF 1990 AT A MEETING HELD ON 11/14/97
William E. Soderberg
WILLIAM E. SODERBERG, P.S., CHAIRMAN

C. Description of monument for corner and accessories established to perpetuate locating the position of the corner:

E-9 I replaced the found capped iron with a 4" x 36" concrete monument w/2" diameter aluminum cap stamped "Macomb County Monument MI Act 345 #25854."

- N 40° W 150.32' - Set P.K. Nail & Macomb Co. Remon. Tag in NE Face of Util. Pole
- N 48° E 144.75' - Set P.K. Nail & Macomb Co. Remon. Tag in NW Face of Util. Pole
- S 87° E 116.40' - Found "X" Cut on NW Bolt on Base of Steel Light Pole
- N 85° W 115.13' - Found "X" Cut on SE Bolt on Base of Steel Light Pole

The selected location is accepted by me and is generally accepted by professional surveyors as the best available evidence of the position of the original corner.

Signed by Randy J. Kolehouse Date 11/14/97
Surveyor's Michigan License No. 25854



751