

LAND CORNER RECORDATION CERTIFICATE  
 Filing Requirement of Act 74, Mich. P.A. 1970

For corners in

MACOMB (County)	Located in:	City of Sterling Heights	Corner Code #
1. Public Land Survey	T <u>2N</u>	R <u>12E</u>	<u>E-11</u>
	T _____	R _____	_____
	T _____	R _____	_____
	T _____	R _____	_____
2. Property Controlling in Section	S _____	T _____	R _____
	S _____	T _____	R _____
3. Miscellaneous Property in Sec.	S _____	T _____	R _____
	S _____	T _____	R _____

STATE OF MICHIGAN  
 REGISTER OF DEEDS


MAR 18 1999

SECTION

Register of Deeds Stamp & File Number

4. Lot No. \_\_\_\_\_, Recorded Plat \_\_\_\_\_  
 5. Private Claims \_\_\_\_\_

I, Bruce Antcliff, in a field survey on September 2 19 98, do hereby certify that under requirements of P.A. 74 Michigan P.A. of 1970, the corner points mentioned in lines 1 and 2 above were in conformance with regulations and rules therefore as required in the current manual of survey instructions of the United States Department of the Interior, Bureau of Land Management or by a decree of a Court of Law and/or that the corner points mentioned in lines 3, 4 and 5 above were in conformance with the rules of the Michigan Board of Land Surveyors or by a Decree of a Court of Law; established, re-established, monumented, re-monumented, recovered, found as expressed below:

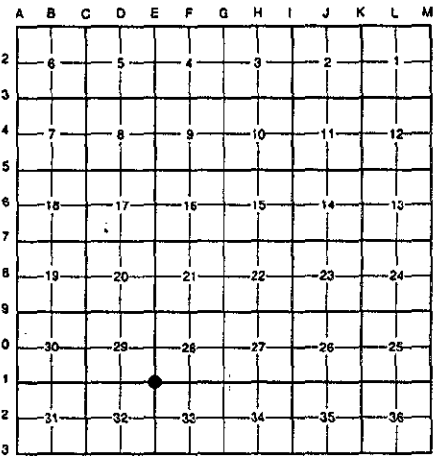

NOTE: Not more than 4 corners, all in the same town and range, may be recorded on this certificate.

A. Description of original monument and accessories and/or subsequent restoration:

E-11	1817	G.L.O. Notes	Wampler	N/A	Post
	1937	Supervisors Plat #6, L. 18 P. 26	McBethy	N/A	N/A

(Continued)

B. Description of corner evidence found and/or method applied in restoring or reestablishing corner:

E-11 I found a 1/2" iron in a monument box on the C/L of 15 Mile Road (conc.) running East and West and the C/L of the median dividing the northbound and southbound lanes of Mound Road (conc.) which checks with witnesses listed below and Supervisor's Plat #6 and Supervisor's Plat of Warren Heights.

L.C.R.C. L. 2940 P. 347	MCRC Wit. File 139
North 104.7' P.K. W Side U.P. (m. 104.64')	SW 131.68' P.K. in Lt. Pole (m. 131.52')
South 50.08' P.K. W Side U.P. (49.95')	NW 140.19' Chis. "X" on Bolt Amoco Sign (m. 140.21')
	NE 122.53' P.K. in Lt. Pole (m. 122.65')
	South 50.46' P.K. in Lt. Pole (m. 49.95')

L.C.R.C. L. 4069 P. 34  
 North 104.63' P.K. W side U.P. (m. 104.64')  
 South 50.05' P.K. W side U.P. (49.95')

Measure North 2655.86' to E-10 (G.L.O. = 2640.0') (Sup. Plat No. 6 = 2655.50')  
 Measure East 2572.12' to F-11 (G.L.O. = 2621.5') (Bart Ind. Park = Calc. 2572.3')  
 Measure South 2626.20' to E-12 (G.L.O. = 2640.0')  
 Measure West 2825.36' to D-11 (G.L.O. = 2702.7')

C. Description of monument for corner and accessories established to perpetuate locating the position of the corner:

E-11 I replaced the found 1/2" iron with a 3/4" x 24" iron rod w/2" diameter aluminum cap stamped "Macomb County Monument MI Act 345 #25826" in an existing monument box.

S 01° E 49.95'	Found P.K. Nail & Washer #19837 in W Side of Utility Pole
S 67° W 131.52'	Found P.K. Nail in NW Side of Utility Pole
S 67° W 131.52'	Set P.K. Nail & Macomb Remon Tag in S Side of Utility Pole
N 00° E 104.64'	Found P.K. Nail & Washer #19837 in W Side of Utility Pole
N 58° W 140.21'	Found Chis. "X" on S Bolt Amoco Sign
N 50° E 122.65'	Set P.K. Nail & Macomb Remon Tag in S Side Utility Pole

ACCEPTED BY THE MACOMB COUNTY SURVEY PEER GROUP AS THE OFFICIAL CORNER UNDER MICHIGAN PUBLIC ACT 345 OF 1990 AT A MEETING HELD ON 10/27/98

William E. Soderberg  
 WILLIAM E. SODERBERG, P.S., CHAIRMAN

The selected location is accepted by me and is generally accepted by professional surveyors as the best available evidence of the position of the original corner.

Signed by Bruce Antcliff Date 11-25-98  
 EARTH TECH  
 Surveyor's Michigan License No. 25826

91 ✓ 856

GUNNEY &  
RECORDS/PARK SECTION

MAR 12 1999

SECTION

A. Description of original monument and accessories and/or subsequent restoration:

E-11	1944	Sup. Plat # Warren Heights Sub., L. 22 P. 44	Lehner	#123	N/A
	1948	Mound Gardens Sub. #1, L. 24 P. 45	Lehner	#123	N/A
	1967	Sterling Ind. Sub., L. 57 P. 35	Webster	#11302	N/A
	1978	L.C.R.C. L. 2940 P. 347	Patterson	#17631	Iron in Monument Box
	1979	Bart Ind. Park #1 L. 75 P. 8	Menzel	#7313	N/A
	1986	L.C.R.C. L. 4069 P. 34	Ward	#22445	Fnd. Iron Pipe
	1993	MCRC Wit. File 139	Campbell	N/A	N/A
	1995	MCRC Wit. File 139	Matz	N/A	N/A

C0863640 LIBER:08565 PAGE:878 09:45A 01/19/1999  
CARMELLA SABAUGH-MACOMB COUNTY, MI REG/DEEDS